


T.27S., R.4W., W.M. SECTION 31

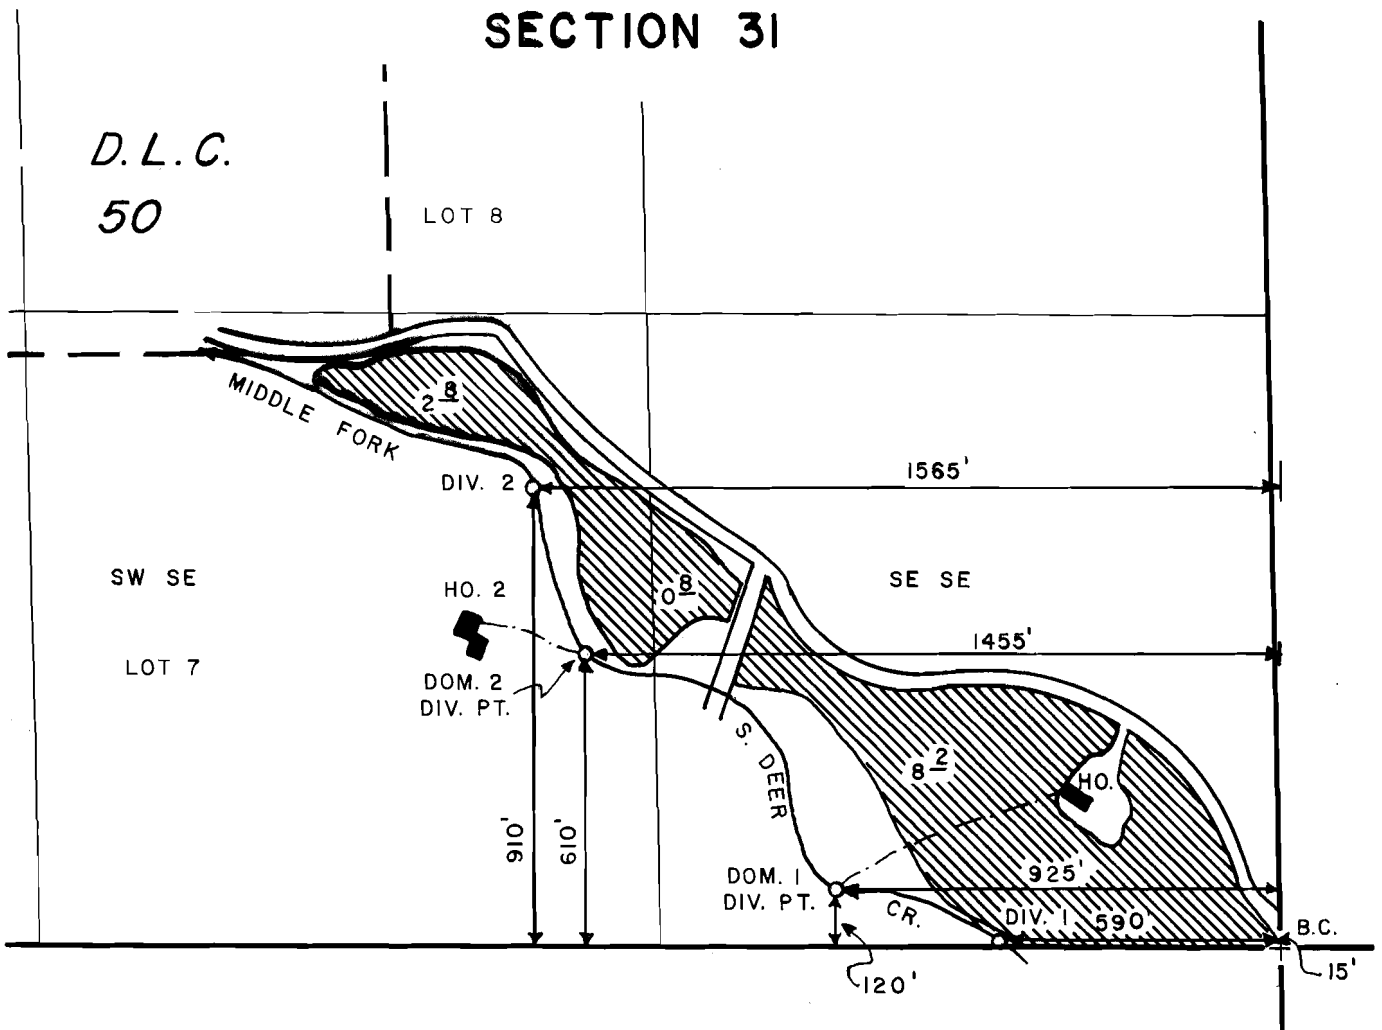

SCALE: 1" = 400'

FINAL PROOF SURVEY UNDER

Application No. 62036 Permit No. 45969
 Application No. 61690 Permit No. 45814
 IN NAME OF

J. R. HARRIS

Surveyed APR. 28 1986, by J. M. SCHMORDE