


T.27S., R.4 W., W.M.

SECTION 31

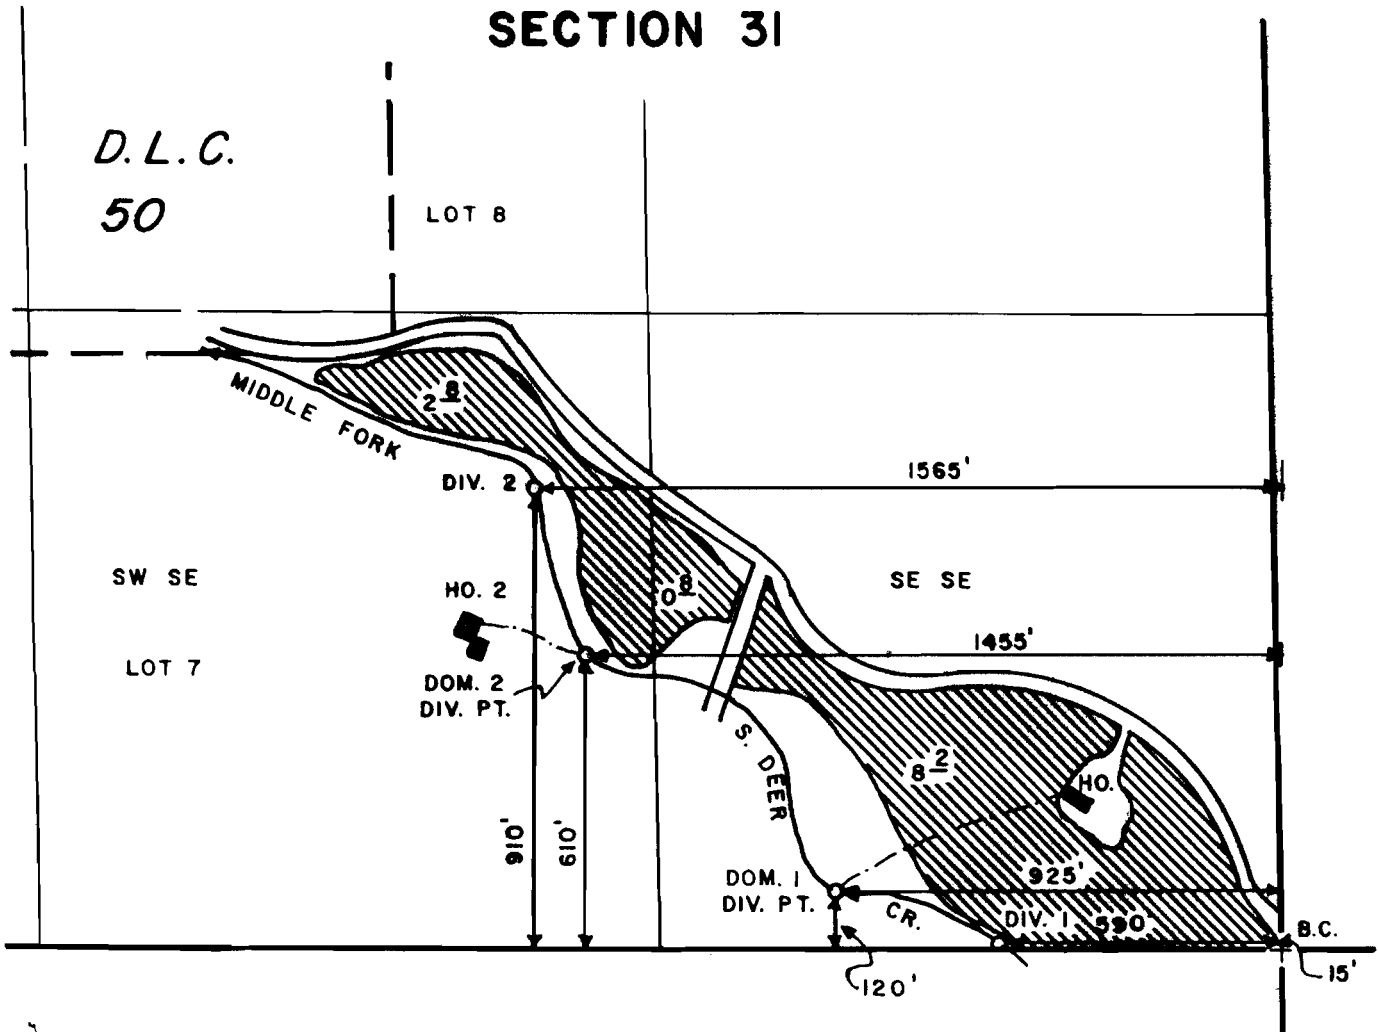

SCALE: 1" = 400'

FINAL PROOF SURVEY
UNDER

Application No. 62036	Permit No. 45969
61690	45814

IN NAME OF

J. R. HARRIS

Surveyed APR. 28 1986, by J. M. SCHMORDE