


T.19 S., R.12 W., WM.

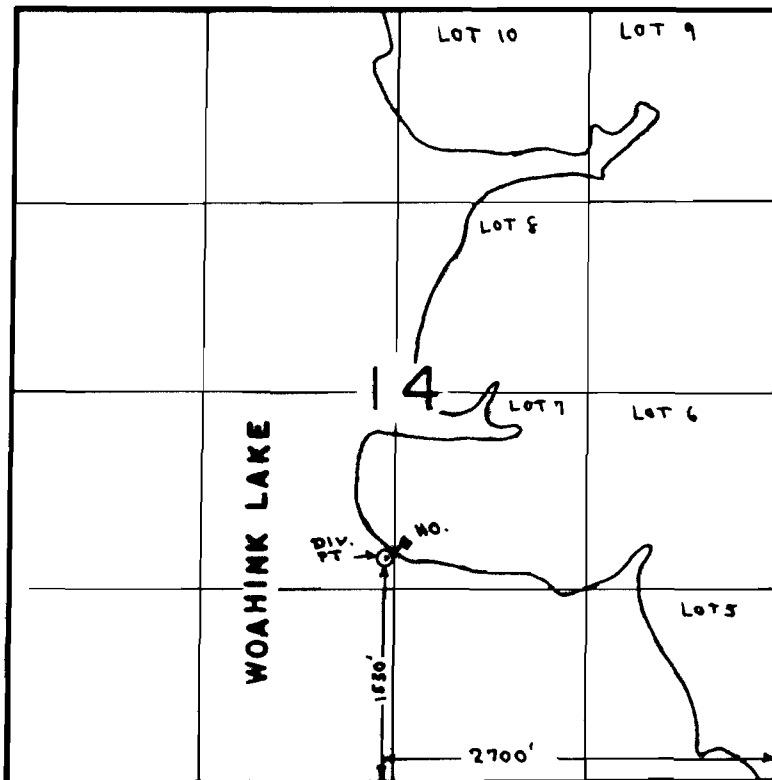

**FINAL PROOF SURVEY**  
UNDER

Application No. 61594 Permit No. 46042  
IN NAME OF

V. THOMPSON & JANET L. SNYDER

Surveyed NOV. 3, 1983, by P. PAGTER