


T. 30S., R. 4 W., W.M.

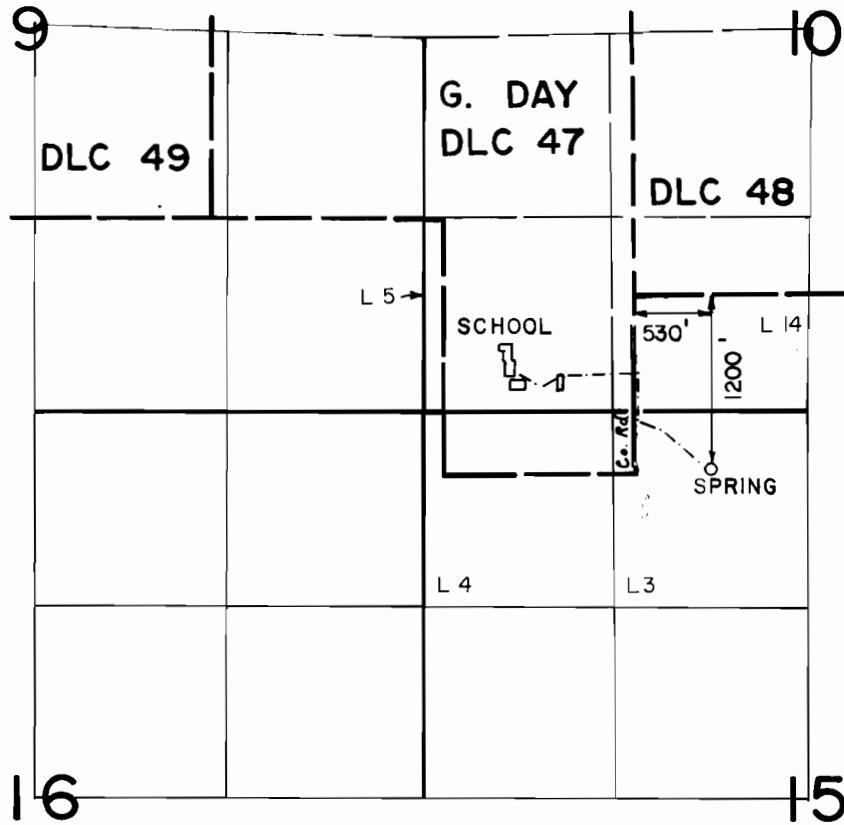

SCALE: 4" = 1 mile

FINAL PROOF SURVEY
UNDER

Application No. 61269... Permit No. 45603.....
IN NAME OF

DAYS CREEK SCHOOL DISTRICT NO. 15

Surveyed AUG...25. 1983, by J.S...DONALDSON