


# T.25S., R.7 W., W.M.

## SECTION 9

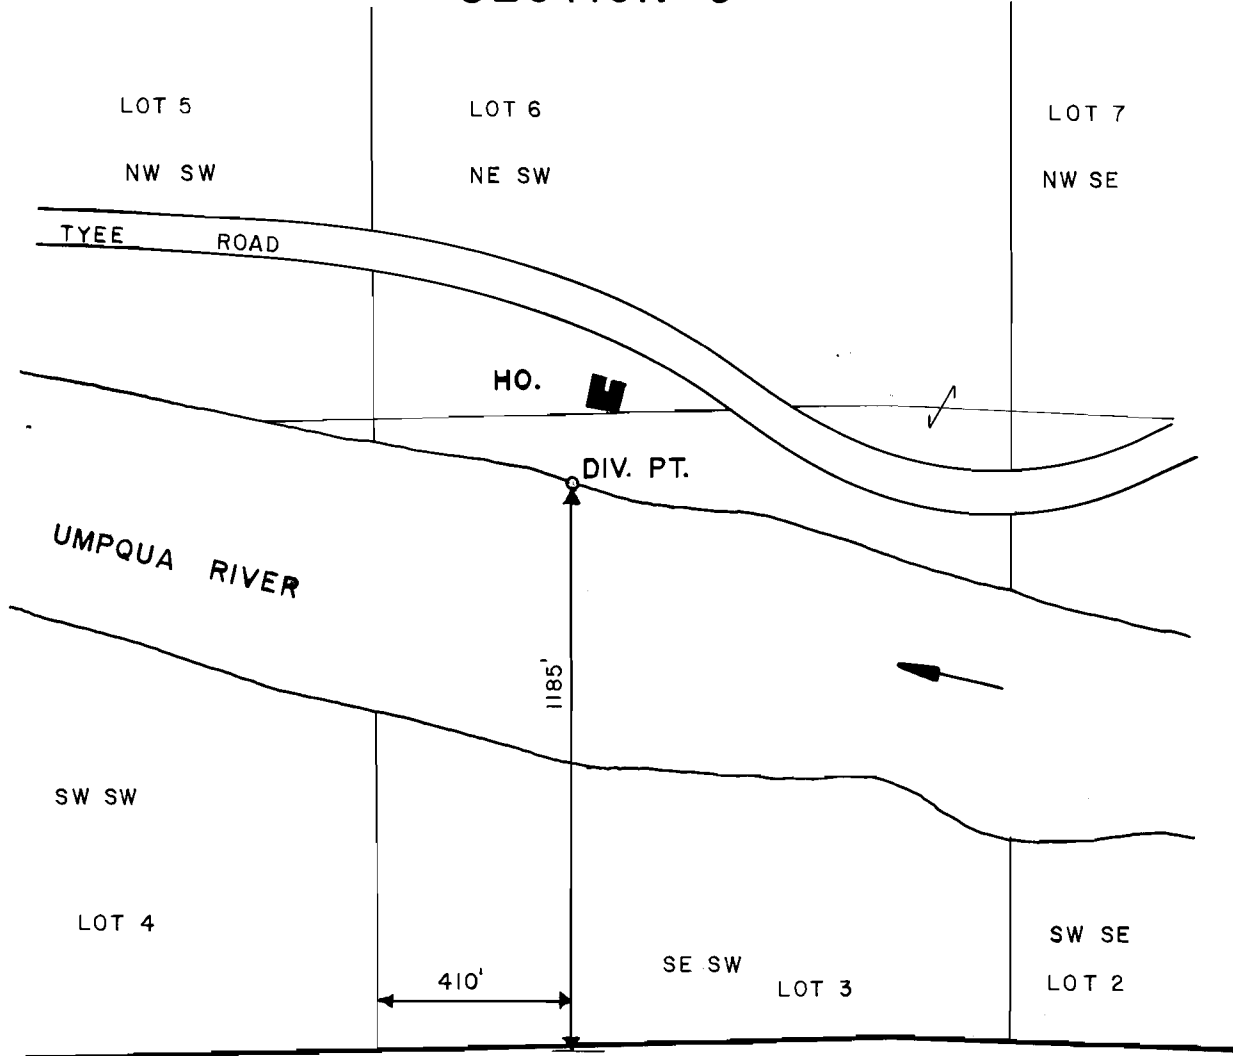

SCALE: 1" = 400'



### FINAL PROOF SURVEY UNDER

Application No. 62832 Permit No. 46601  
 IN NAME OF

**LYLE & FLOANNE BOWEN**

Surveyed AUG. 5 1986, by J. M. SCHMORDE