


# T. 3 S., R. 1 E., W.M.

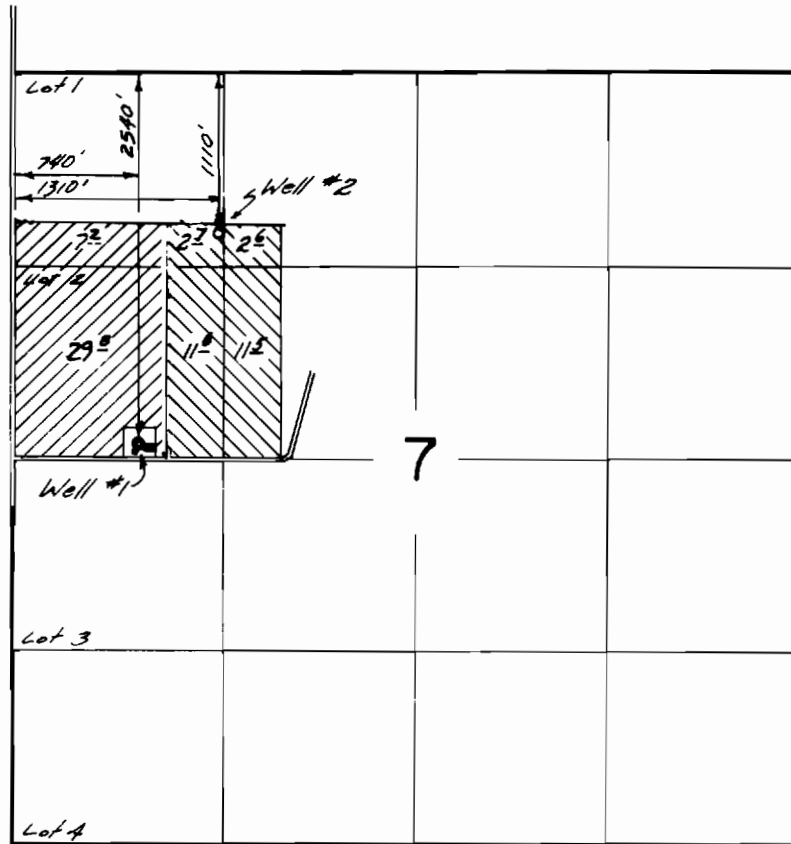

## FINAL PROOF SURVEY UNDER

Application No. G-6455 Permit No. G-6054  
IN NAME OF

F. EDMUNDS JR. & A. HARRINGTON

Surveyed MAR. 11, 1980, by R.G. MUCKEN  
AUG. 10, 1981 S. BROWN

DFK-30-11 *MB*