


T.5N.R.2W.W.M.

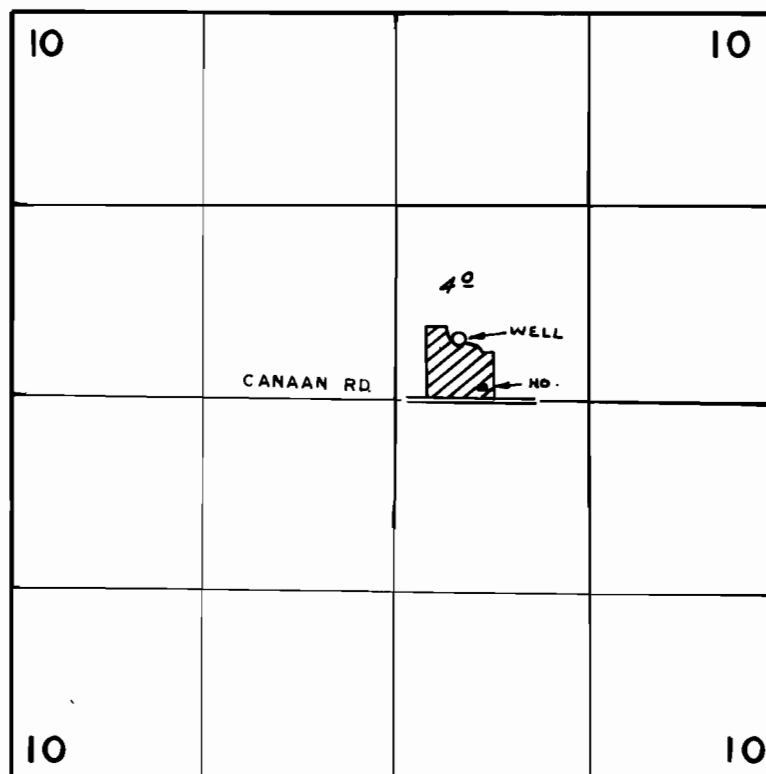

WELL LOC: 420' N. & 440' E. FROM CEN. SEC. 10

FINAL PROOF SURVEY
UNDER

Application No. G-6473. Permit No. G-6068...
IN NAME OF

.....CARL R. KLIPPSTEIN.....

Surveyed APRIL 10, 1980, by R.G. MUCKEN....