


T. 2S., R. 39E., W.M.

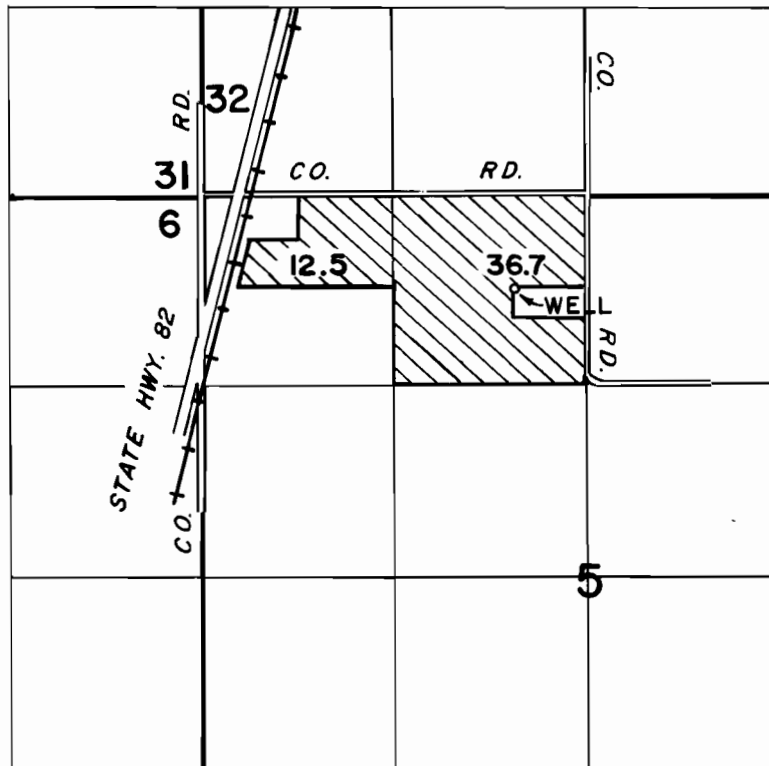

WELL IS LOCATED 630' S. & 480' W. OF THE
N. 1/4 CORNER OF SEC. 5, T.2S., R.39E., W.M.

FINAL PROOF SURVEY
UNDER

Application No. G-6494 Permit No. G-6111
IN NAME OF

CHARLES & NORMA SLATER

Surveyed AUG. 22, 1983, by V. CHURCH