


T.8S., R.38E., W.M.

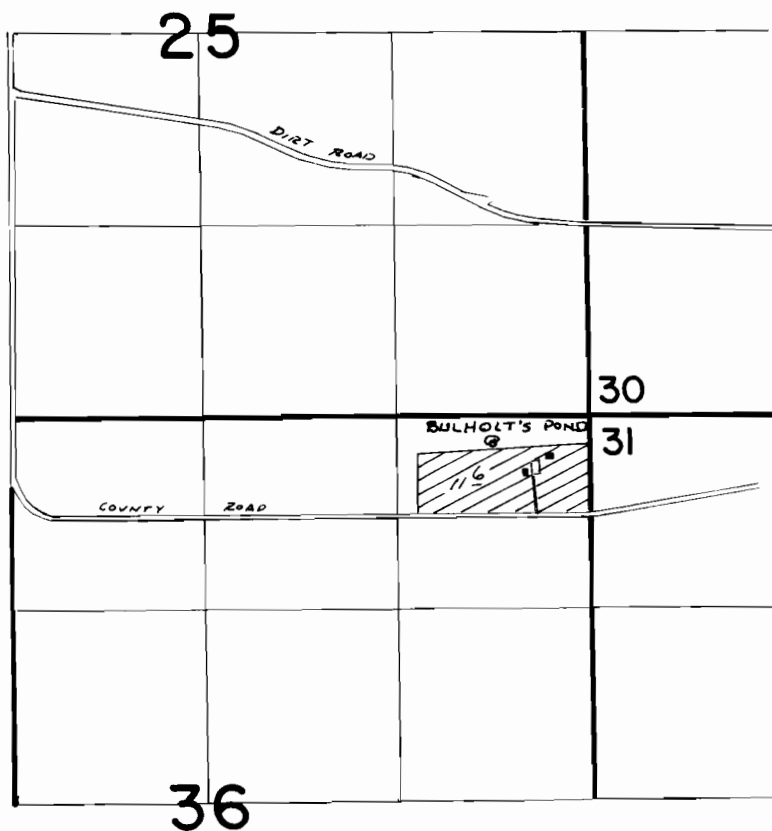

POND LOC: 190'S. & 670W. FROM NE COR. SEC 36

FINAL PROOF SURVEY
UNDER

Application No. G:6518.. Permit No. G:6130.....
IN NAME OF

WALLACE H. & CAROL V. BUHOLTS

Surveyed JULY 15..... 1982., by V.R. Church.....