


T.4N.R.2W.W.M.

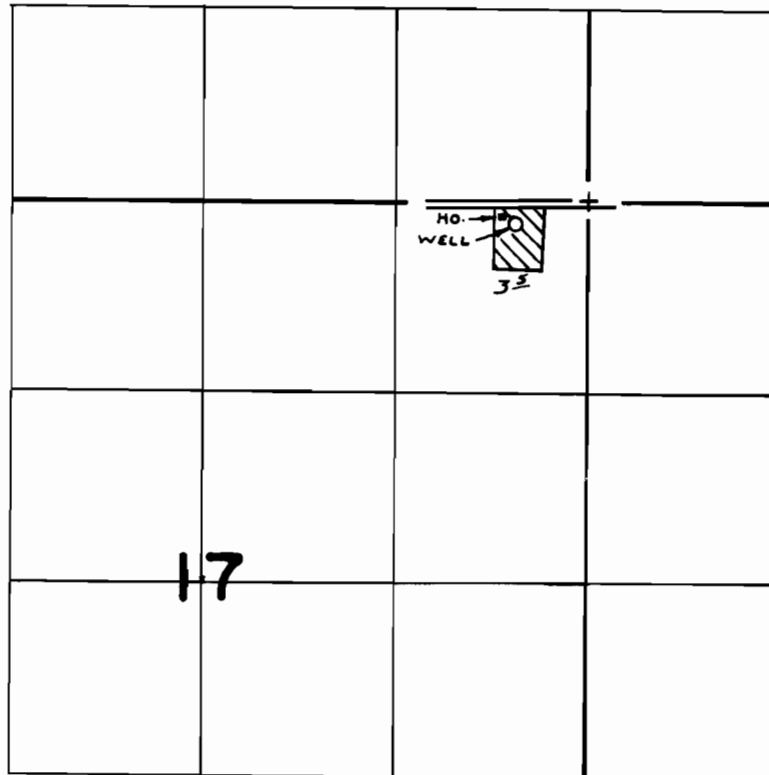

WELL LOC: 150' S. & 300' W. FROM N.E. COR. SEC. 17

FINAL PROOF SURVEY
UNDER

Application No. ~~G-6593~~ Permit No. ~~G-6179~~...
IN NAME OF

.....CYRIEL J. STEYAERT.....

Surveyed MAY 26, 1976, by L. H. NUNN...
APR 9, 1980 R. MUCKEN