T.19S.R.1&2W.W.M.

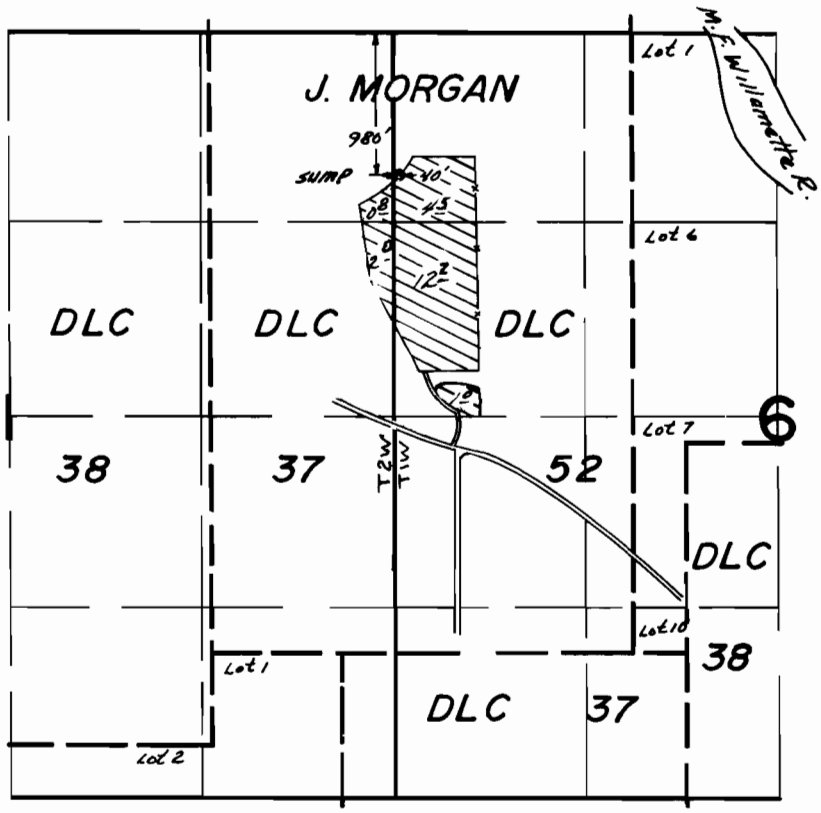

FINAL PROOF SURVEY

UNDER

Application No. G-6597 Permit No. G-6183.....
IN NAME OF

.....CLIFFORD A. EVERETT.....

Surveyed June 29.. 1979, by S.C. BROWN.....

DBQ-4JJ-46 EBR