
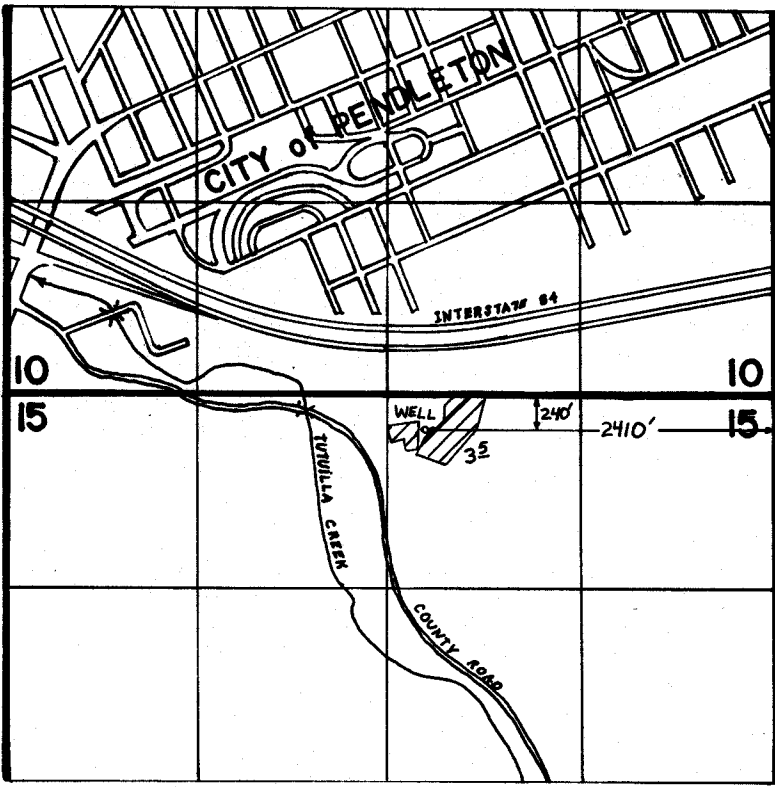


SL 981  
G-60

# T.2N. R.32E. W.M.

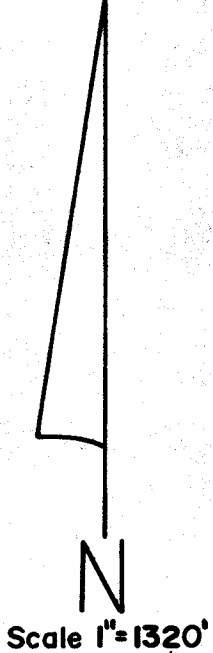

## FINAL PROOF SURVEY UNDER

Application No. G-6671. Permit No. G-6226  
IN NAME OF

..... LORAN R. or HAZEL MURPHY .....

Surveyed OCT. 28 19 80, by VERNON L. CHURCH.  
3-27 87