


T.13S.,R.3W.,W.M.

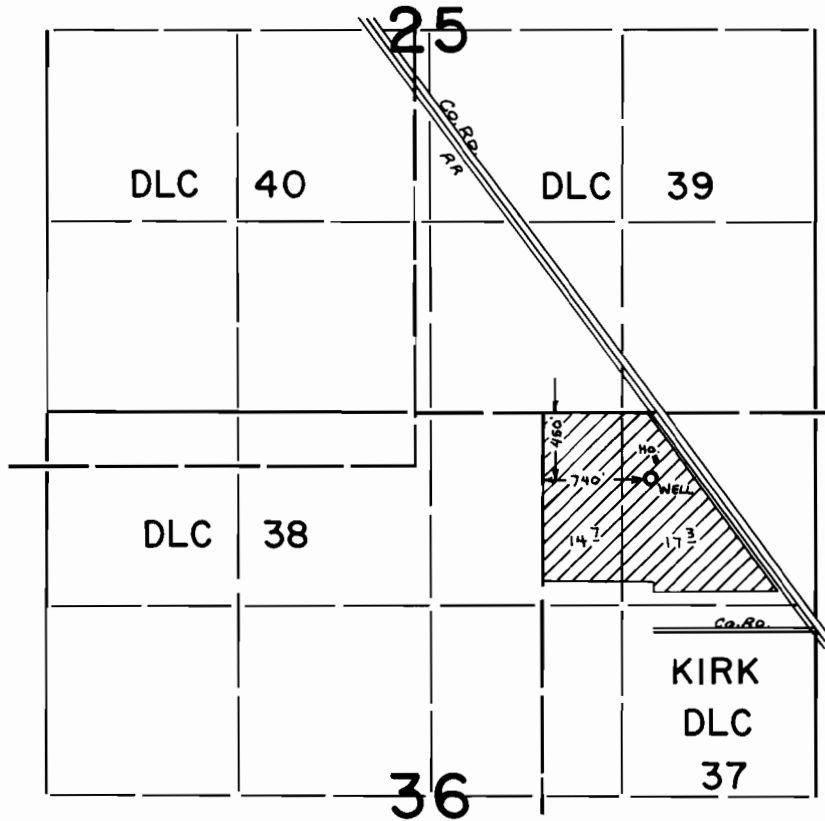

FINAL PROOF SURVEY
UNDER

Application No. ..G:-67.18. Permit No.G:-625.6..
IN NAME OF

GENE... E. ... & ... ROSEMARY ... THORNTON

Surveyed April..23.. 19.82., by ..L..M..TOLL.....