


T.1S. R.3W., W.M.

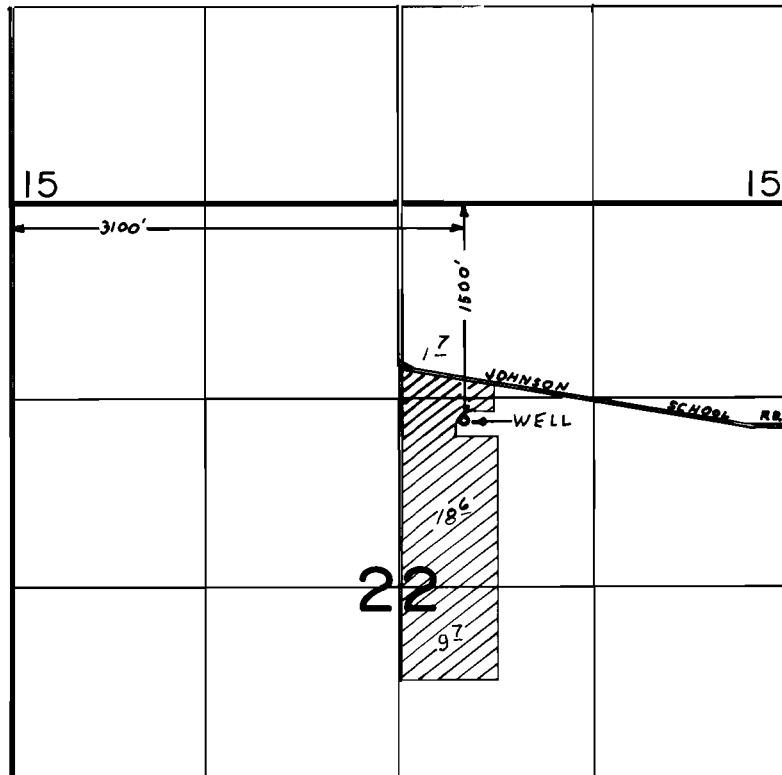

SCALE: 1"=1320'

FINAL PROOF SURVEY UNDER

Application No. G-6719... Permit No. G-6257...
IN NAME OF

.....GARY W. DUYCK.....

Surveyed MAY 4, 1977, by D.M. NORBY.....
Sept. 25, 1984 B.W. BISHOP

3-7-85
BWB

DFR-20-165

Bef