


T. 40 S., R. 7 W., W.M.

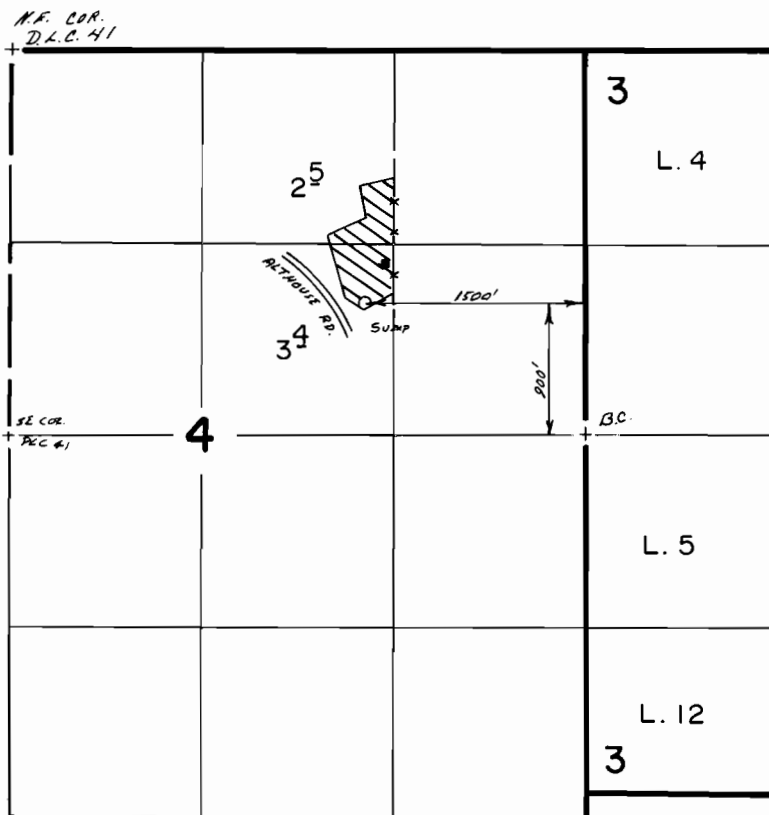

Scale: 1" = 1320'

FINAL PROOF SURVEY UNDER

Application No. **G-6747** Permit No. **G-6270**
IN NAME OF

CELESTA A. YEOMAN

Surveyed **MAY 6, 1986**, by **B. S. JAMES**