


T.4S., R.3W., W.M.

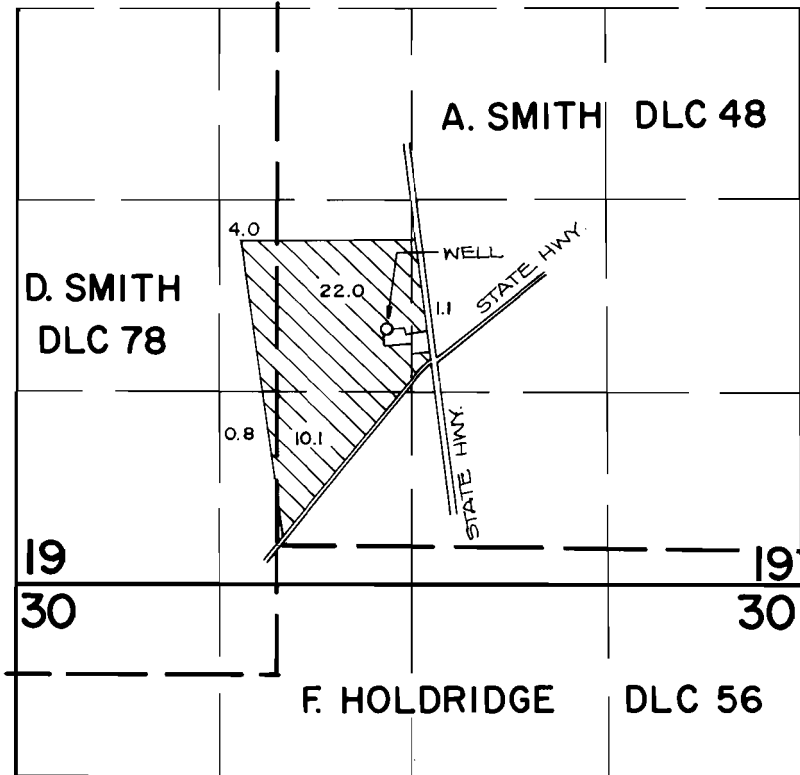

WELL LOCATION: 1500 FT. N. AND 750 FT. E. FROM THE S.W. CORNER OF THE A. SMITH DLC NO. 48.

### FINAL PROOF SURVEY

UNDER

SCALE: 4" = 1 MILE

Application No. G-6801.. Permit No. G-6308....  
IN NAME OF

.....EARL G. SMITH.....

Surveyed MAY 17, 1984, by P. Pagan

