


T. 2S., R. 38E., W.M.

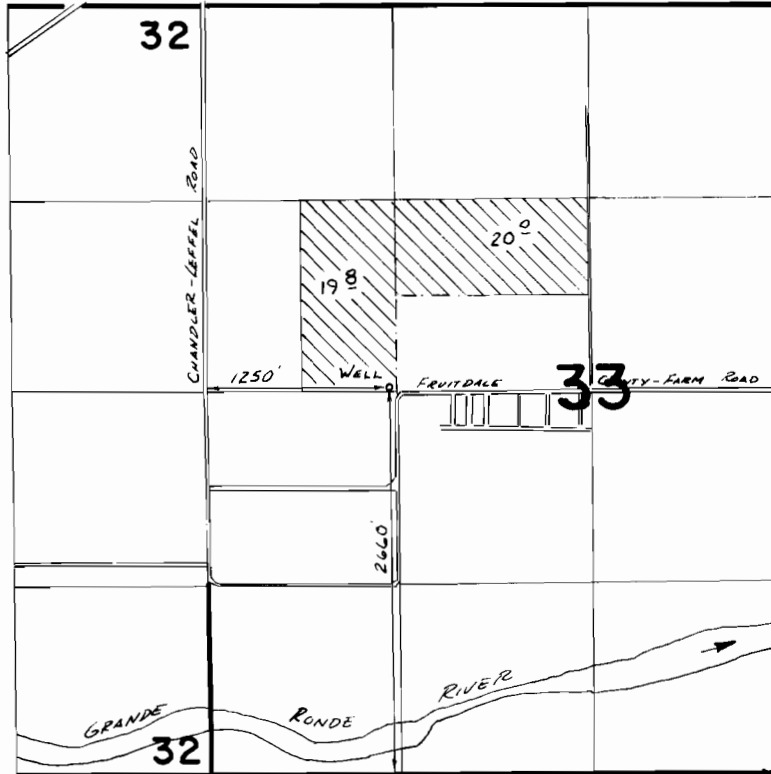

FINAL PROOF SURVEY
UNDER

Application No. **G-6842** Permit No. **G-6331**....
IN NAME OF

.....**KENNETH BERRY**.....

Surveyed *Aug. 25*.... 19*83*., by *V.L. Church*.....