


T.4S., R.6W., W.M.
(SECTION 24)

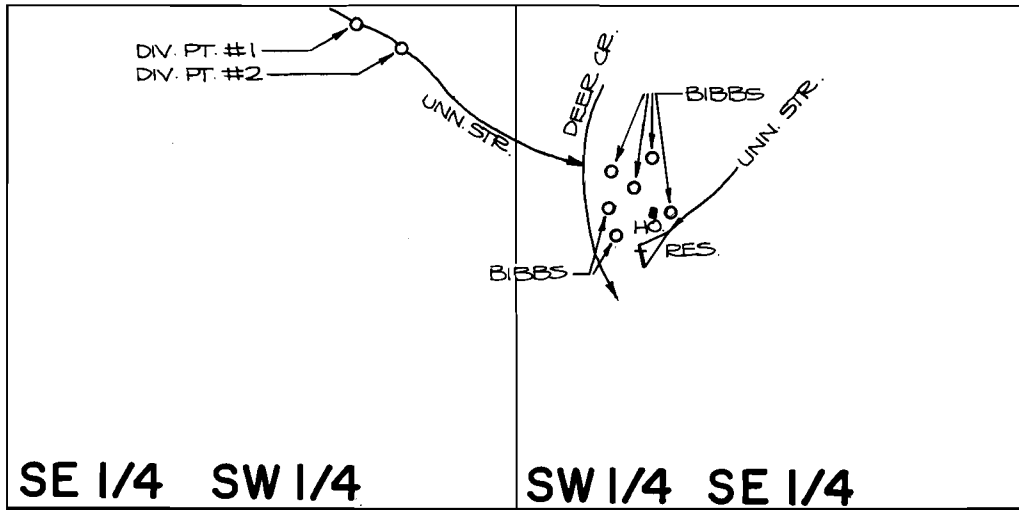

DAM LOCATION: 670 FT. N. AND 320 FT. E.; DIV. PT. #1 LOCATION: 1270 FT. N. AND 410 FT. W.; DIV. PT. #2 LOCATION: 1200 FT. N. AND 290 FT. W.; ALL FROM THE S. 1/4 CORNER OF SECTION 24.

FINAL PROOF SURVEY
UNDER

R-45239 R-5262
Application No. 45358... Permit No. 33283.....
IN NAME OF

.....**E. M. HUNTLEY**.....

Surveyed SEPT. 19, 1984., by *P. Pagter*.....



SCALE: 1" = 500'