


T.2N., R.42E., W.M.

SCALE: 1"=1320'

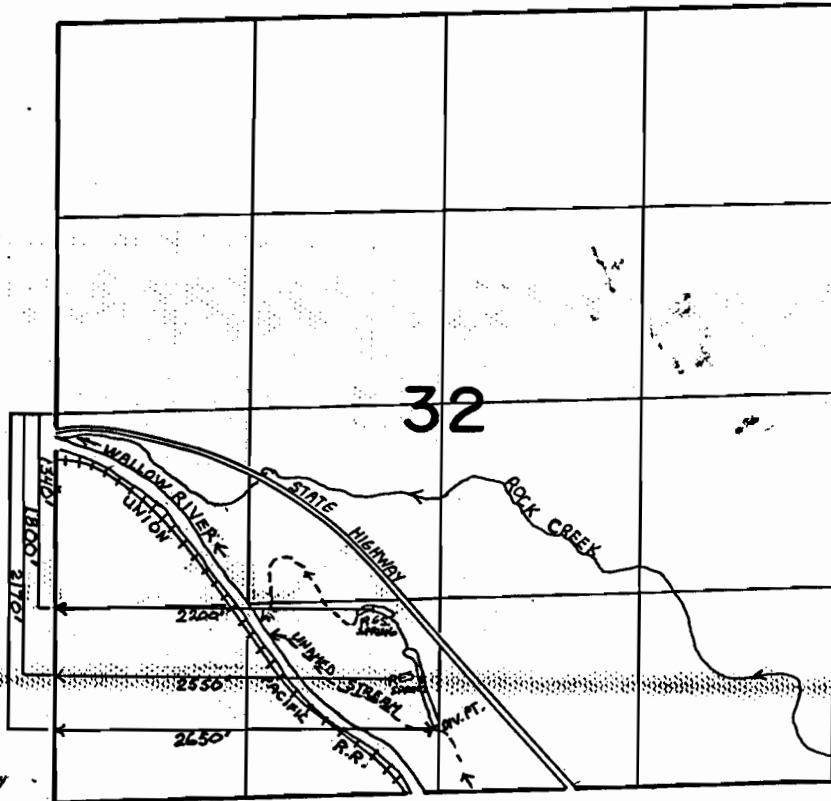

FINAL PROOF SURVEY

UNDER

R-48662

R-5783

Application No. ~~48663~~ Permit No. ~~35814~~.....

IN NAME OF

LEONARD KNIGHT

Surveyed Aug. 15..... 1985.., by V.L. CHURCH.....