


T. 2 N., R. 42 E., W.M.

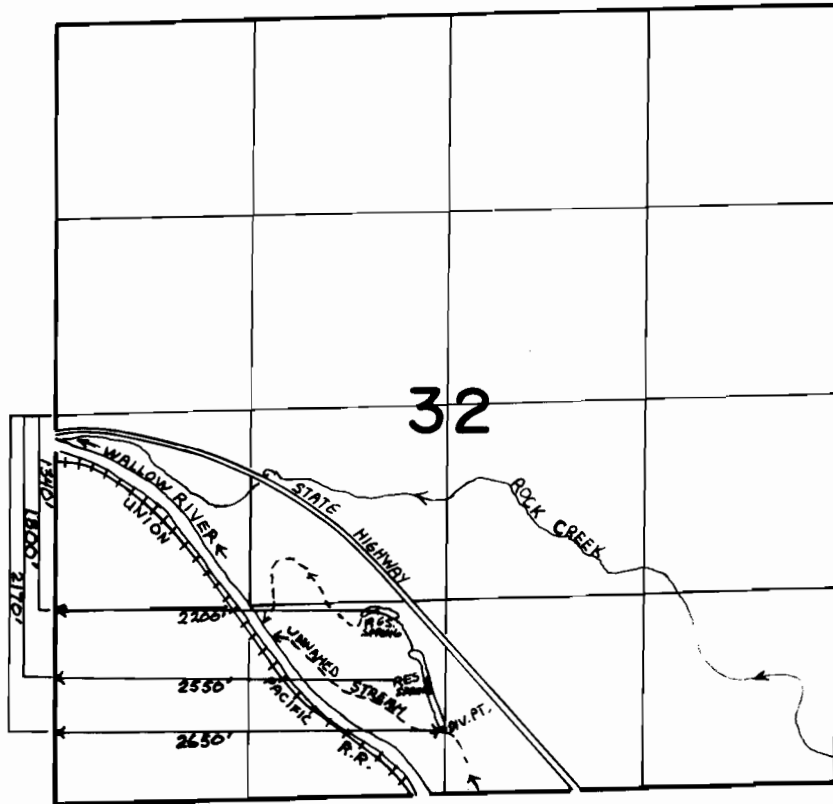

SCALE: 1"=1320'



FINAL PROOF SURVEY UNDER

R-48662 R-5783

Application No. ~~48663~~ Permit No. ~~35814~~.....

IN NAME OF

LEONARD KNIGHT

Surveyed Aug. 15..... 1935.., by V. L. CHURCH.....