


T. 33S., R. 9 W., W. M.

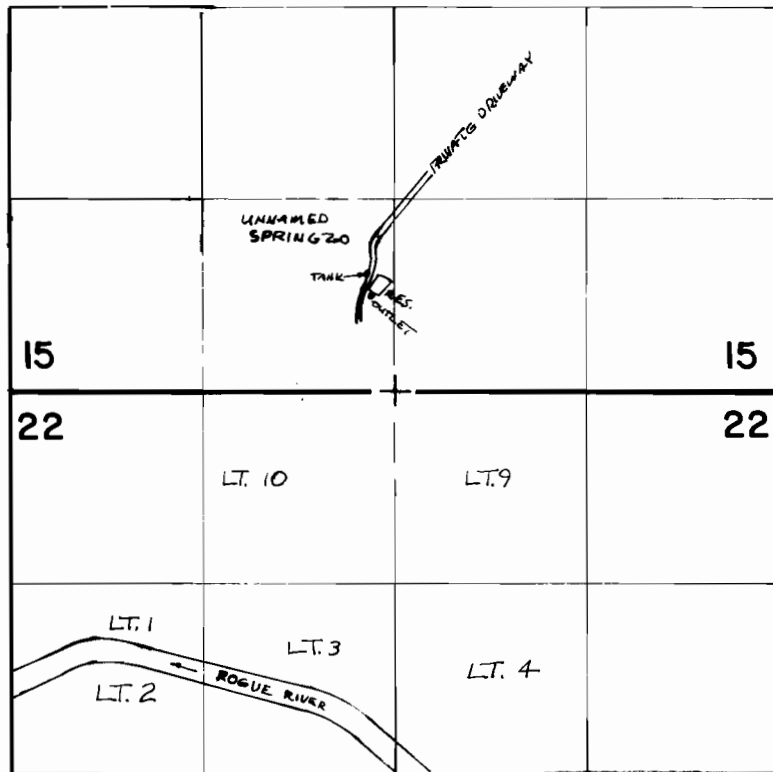

SPRING IS 275' S. & 330' E. ; RES. OUTLET IS 660' S. & 160' E. BOTH FROM NE. COR. SE 1/4 SW 1/4 OF SEC. 15

SCALE 1" = 1320'

FINAL PROOF SURVEY

UNDER

R-48335

R-5800

48334

35918

Application No. Permit No.

IN NAME OF

MARGERY D. BOYDEN

Surveyed SEPT. 26 1984, by J. WOODROOF.