


T.8S. R.5W. W.M.

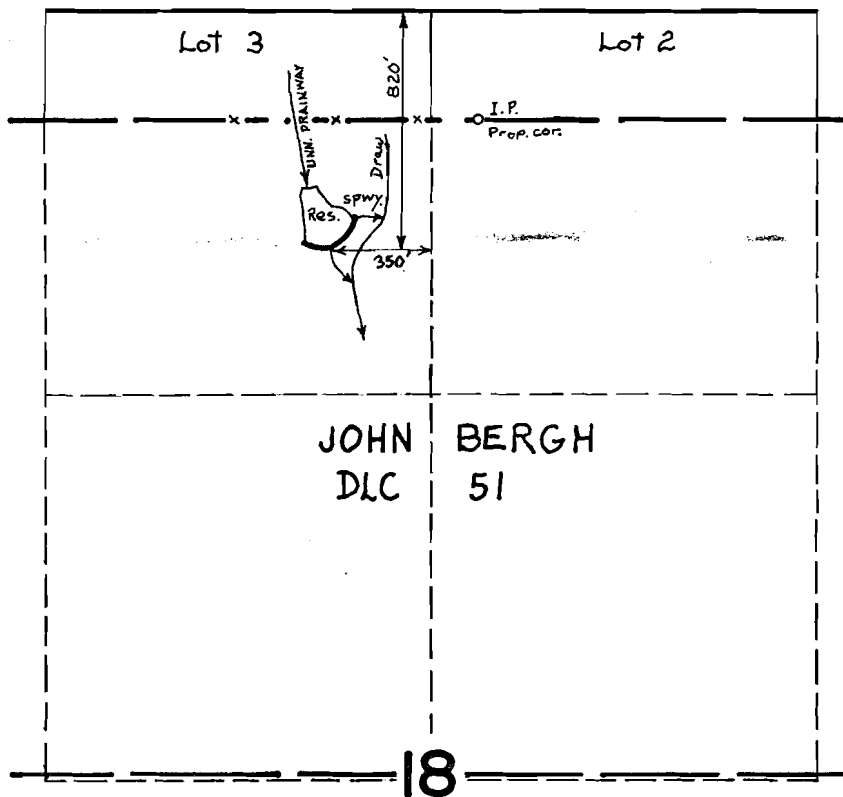

SCALE: 1" = 660'

FINAL PROOF SURVEY UNDER

R-48251 R-5866
Application No. 48252 Permit No. 36231
IN NAME OF

Donald E. & Alene I. Innes

Surveyed AUG. 12 1976, by C. KING