


T.38S., R.8W., W.M.
Sec. 22

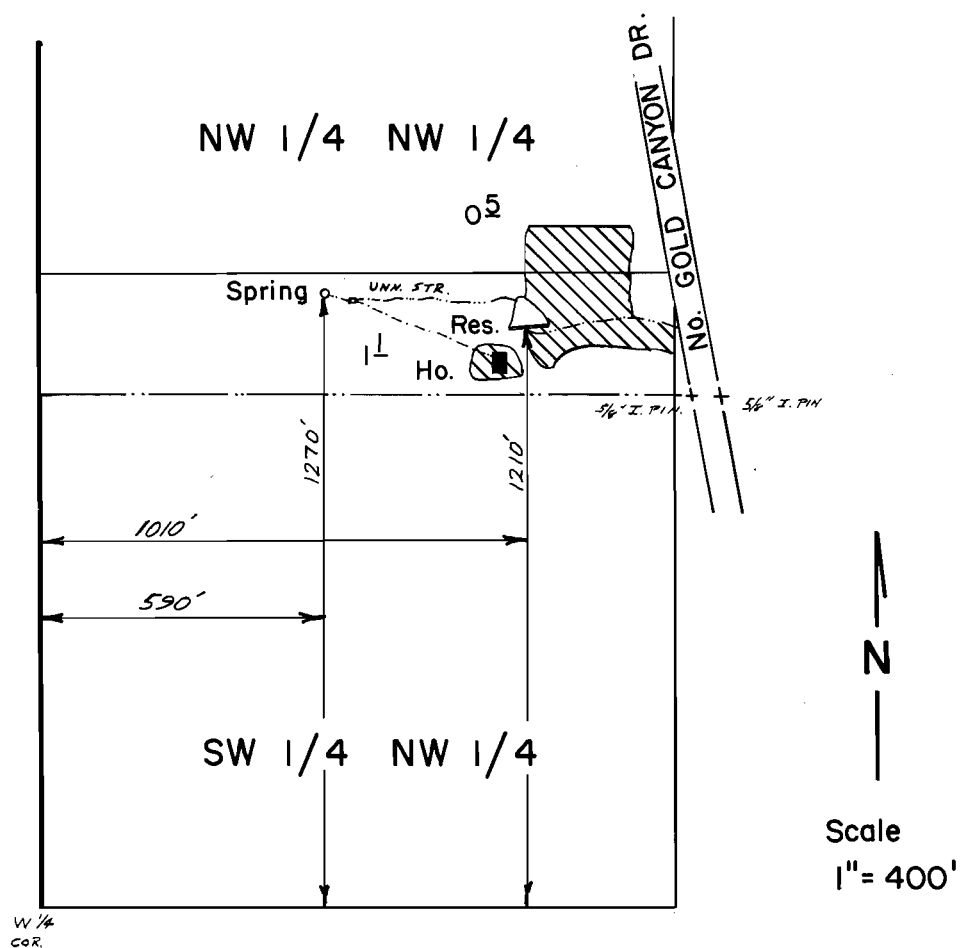

FINAL PROOF SURVEY
UNDER

R-48466

R-5885

Application No. 48467 Permit No. 36375.....
IN NAME OF

LARRY D. EDMISTON.....

Surveyed Nov. 7..... 1984, by J.R. WOODROOF