


T.10S.,R.5W.,W.M.

Section 36

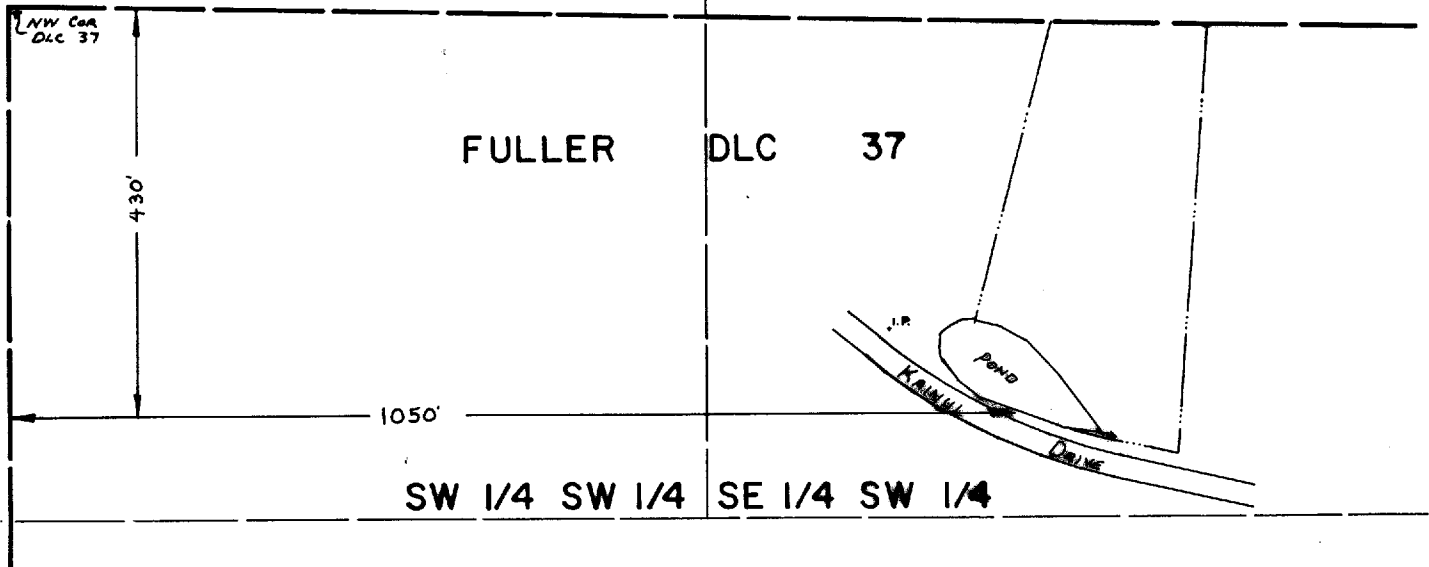

SCALE: 1" = 200'

FINAL PROOF SURVEY
UNDER

Application No. R-48558 48559 Permit No. R-6130 37886
IN NAME OF

ROBERT E. CANFIELD

Surveyed Aug. 27, 1982, by L. M. TOLL