


T. 9S., R. 1E., W. 1M.

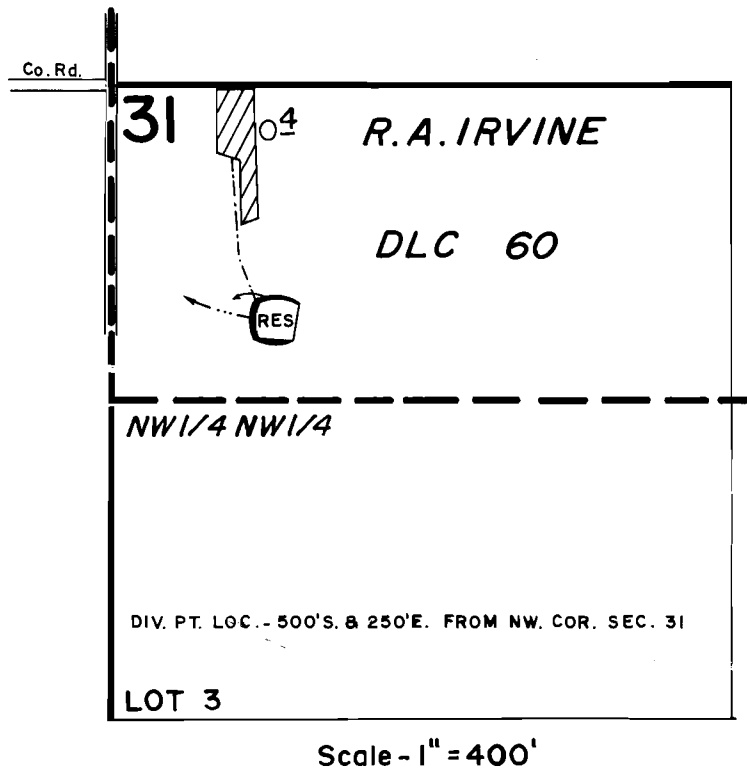

FINAL PROOF SURVEY
UNDER

R-53169 R-6219
Application No. ~~53170~~ Permit No. ~~38793~~
IN NAME OF

HASKEL N. HUNTLEY

Surveyed April 26, 1979, by S.C. BROWN