


T. 6S., R. 6W., W.M.

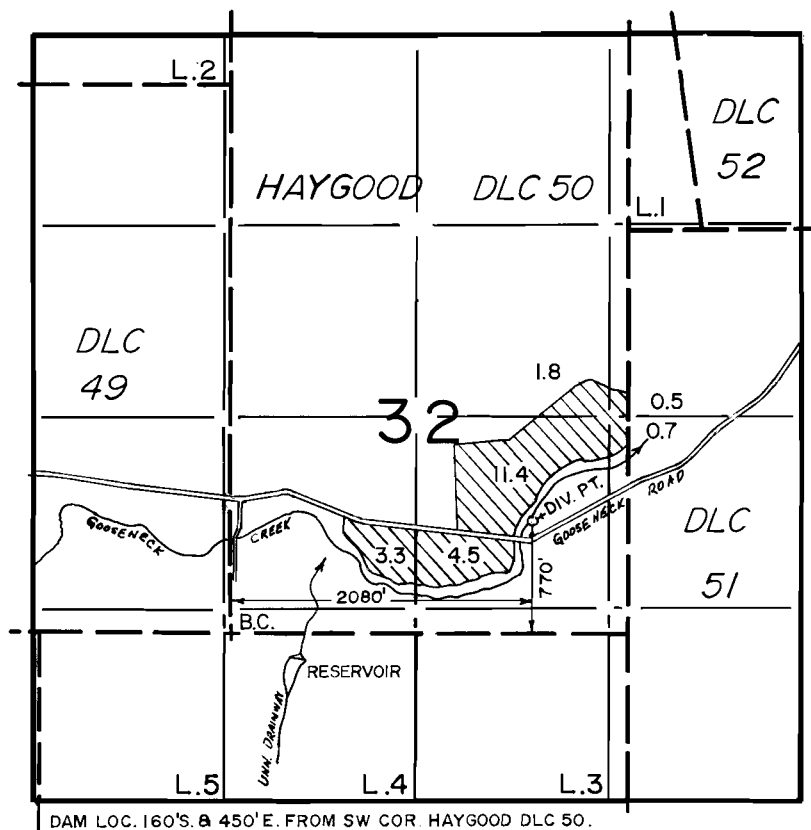

**FINAL PROOF SURVEY**  
UNDER

R-51260                      R-6221  
Application No. 51261      Permit No. 38803  
IN NAME OF

FRED RHODES

Surveyed ..MAY. 31.... 19.79., by ..R.G. MUCKEN.....