


T. 6S., R. 6W., W.M.

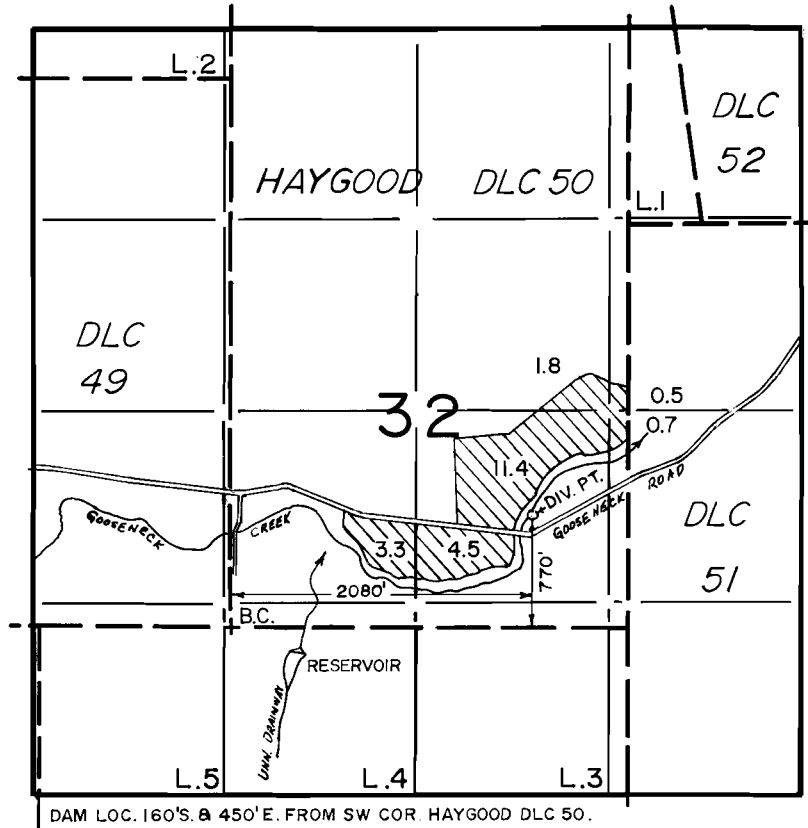

FINAL PROOF SURVEY
UNDER

R-51260 R-6221
Application No. 51261 Permit No. 38803
IN NAME OF

FRED RHODES

Surveyed ..MAY. 31.... 19.79., by ..R.G. MUCKEN.....