
T. 10S. R. 1W. W.M.

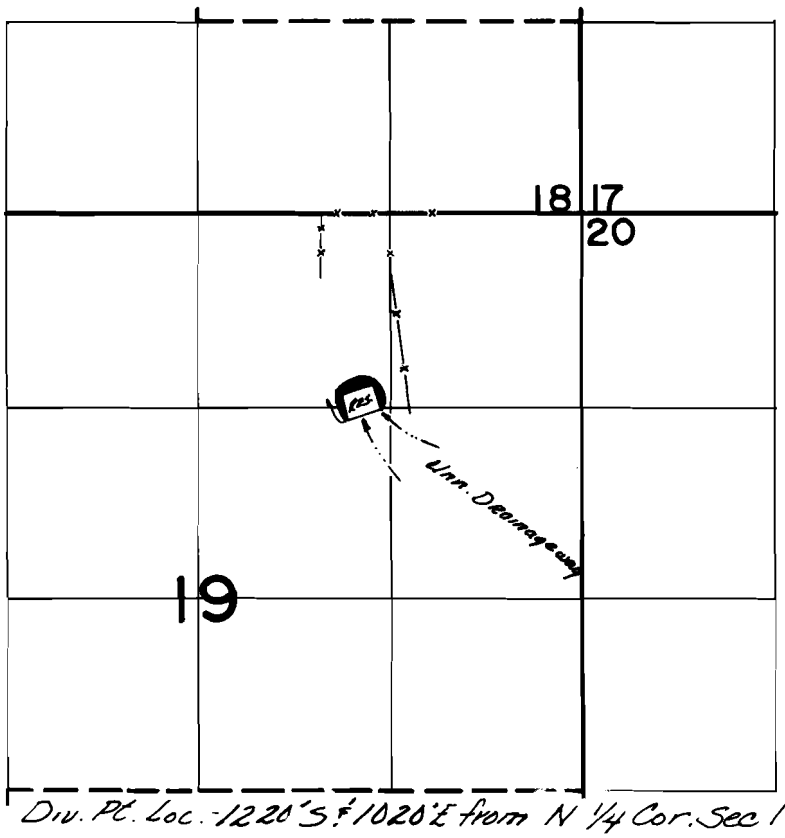

FINAL PROOF SURVEY

UNDER

R-53301 R-6330

Application No. 53302. Permit No. 39549....

IN NAME OF

L. GRAY BUCKNER

Surveyed April 25, 1979., by S.C. BROWN.....

PTS-1979-B CLR.