


T. 4 S., R. 3 W., W. M.

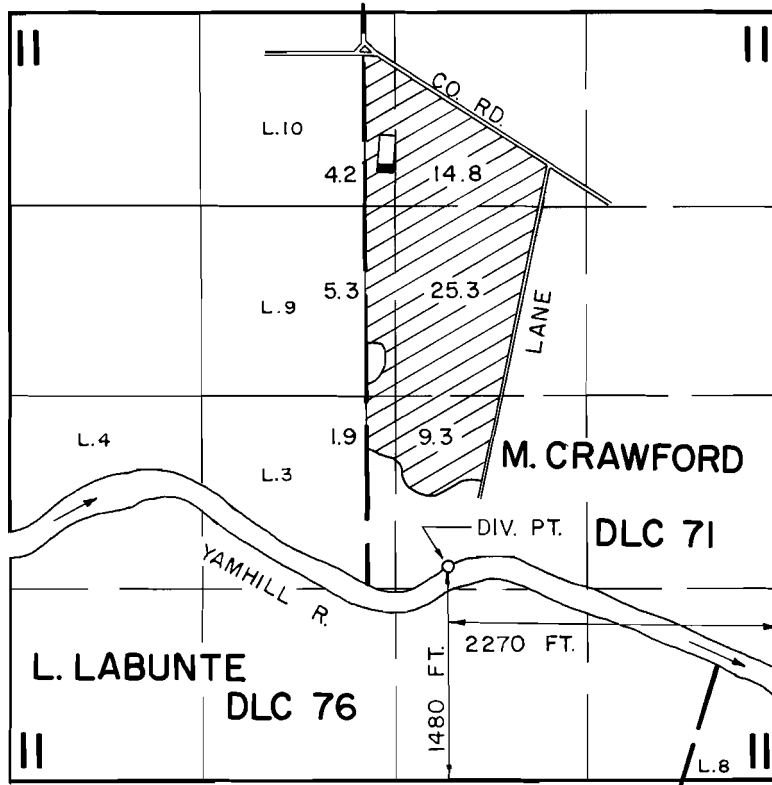

SCALE: 4" = 1 MILE

FINAL PROOF SURVEY
UNDER

Application No. 50082.. Permit No. 37131.....
IN NAME OF

..... RIVERWOOD GOLF COURSE

Surveyed JUNE 18, 1984., by P. Paster.....