


T. 38 S. & 39 S., R. 7 W., W.M.

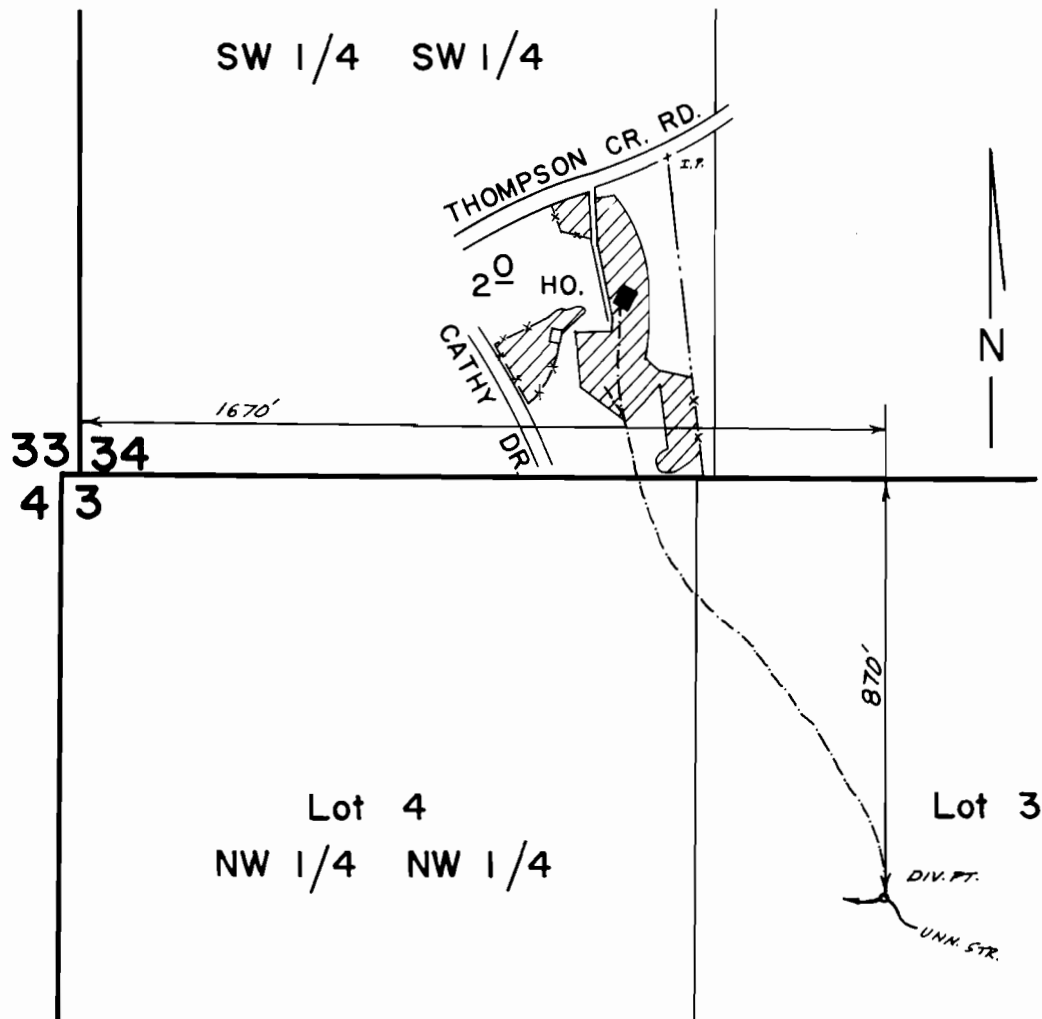

Scale 1" = 400'

FINAL PROOF SURVEY
UNDER

Application No. 54805 Permit No. 41116
IN NAME OF

BEVERLY BABB

Surveyed July 15, 1986, by B.S. JAMES