


T.6N.,R.6W.,W.M.

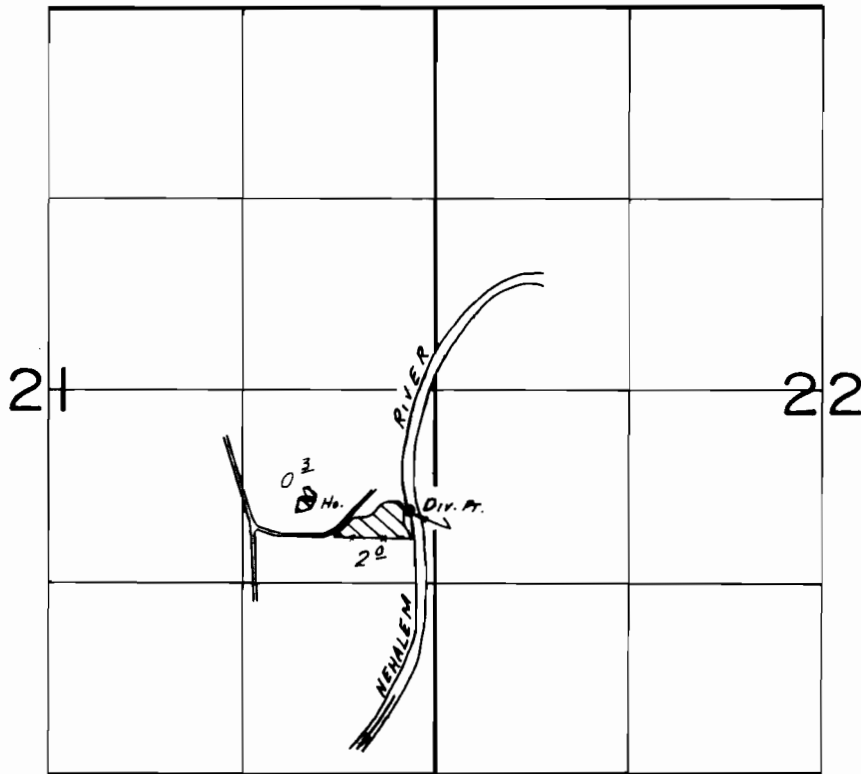

*Div. Pt. Loc: 1810' N. & 180' N. FROM SE COR. SEC. 21.*

SCALE: 1" = 1320

**FINAL PROOF SURVEY**  
UNDER

Application No. 54900. Permit No. 41171.....  
IN NAME OF

.....DONALD JAMES DAVIS.....

Surveyed July 10... 1984, by B.W. BISHOP.....