


T. 40 S., R. 9 W., W.M.

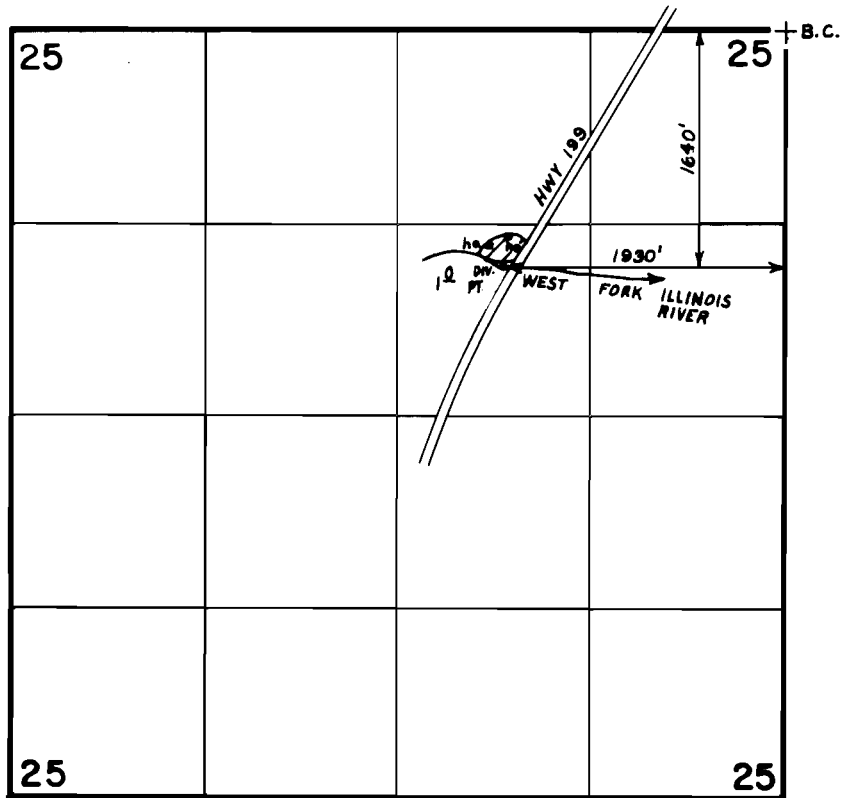

Scale: 4" = 1 mile

FINAL PROOF SURVEY
UNDER

Application No. **55159** Permit No. **41345**
IN NAME OF

WALLACE & ROSE RUSSELL

Surveyed **MAR. 26** 19**84**, by **B. S. JAMES**