


T.11S., R.8W., W.M.

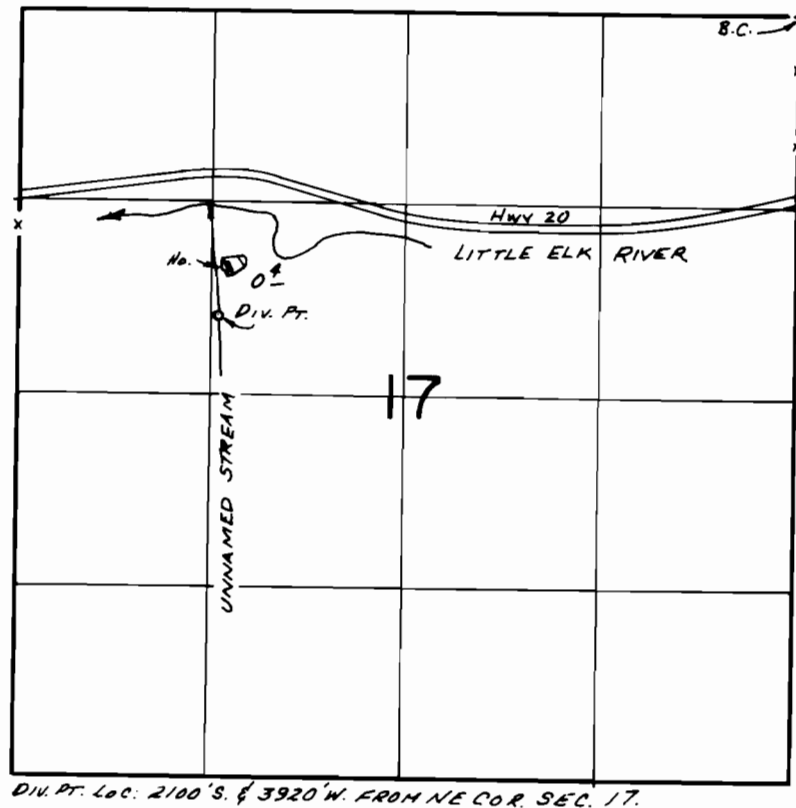

FINAL PROOF SURVEY
UNDER

Application No. 54925.. Permit No. 41370.....
IN NAME OF

BRUCE A. McLEAN - BROMACK HOLDING LTD.

Surveyed Sept. 21... 1983, by L.M. TOLL.....