


T. 37S., R. 6W., W.M.

Sec. 20

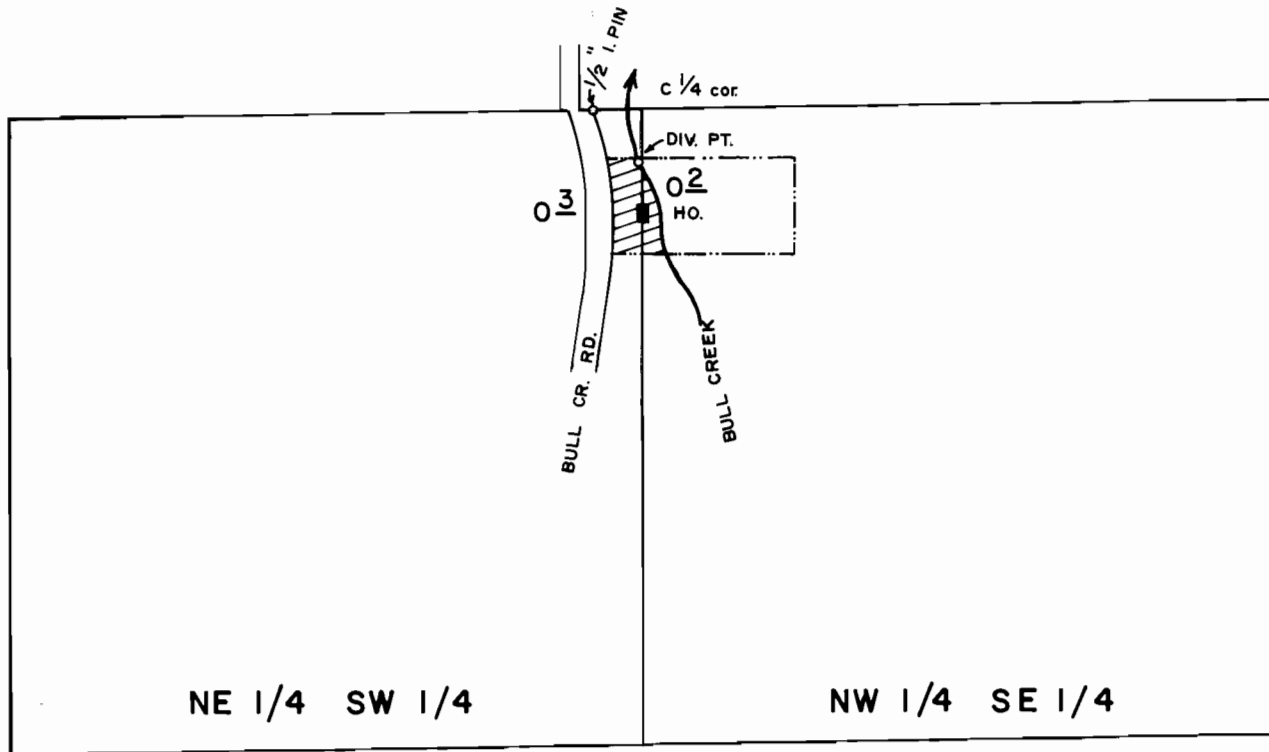

DIV. PT. : 100'S & 10' W FROM CENTER 1/4 COR.

FINAL PROOF SURVEY
UNDER

Application No. 55995. Permit No. 42059.....
IN NAME OF

.....WILLIAM.....D.....BREEDEN.....

Surveyed Oct..24, 1983, by B.S. JAMES.....

Scale 1" = 400'