


# T.4N.R.3W.W.M.

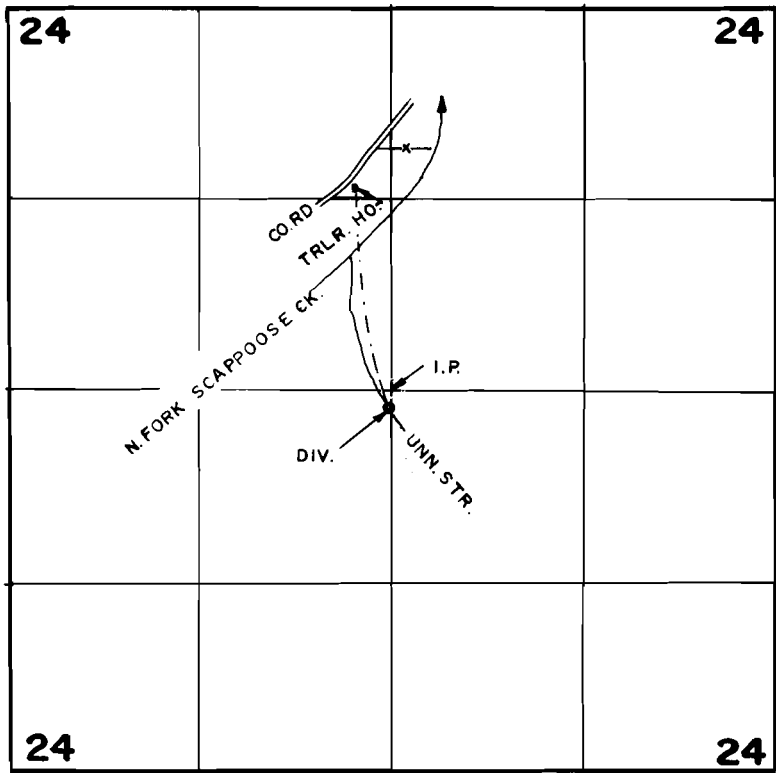

DIV. PT. LOC.: 100' S. & 10' W. FROM CEN. SEC. 24

## FINAL PROOF SURVEY UNDER

Application No. 5551Q.... Permit No. 42528.....  
IN NAME OF

.....SHIRLEY J. SLEIGHTAM.....

Surveyed APRIL 10, 1980., by R.G. MUCKEN.....