


T. 2 S., R. 9 W., W.M.

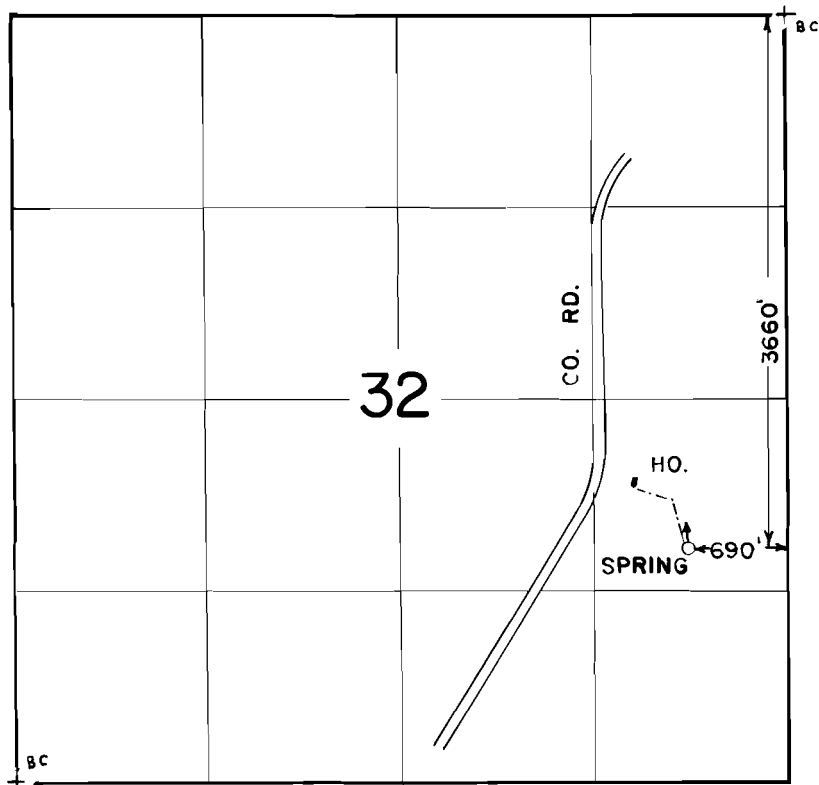

N

SCALE
1" = 1320'

FINAL PROOF SURVEY
UNDER

Application No. 57320 Permit No. 42987
IN NAME OF

RICHARD HOLT

Surveyed JUL 30 1984, by P. PAGTER