
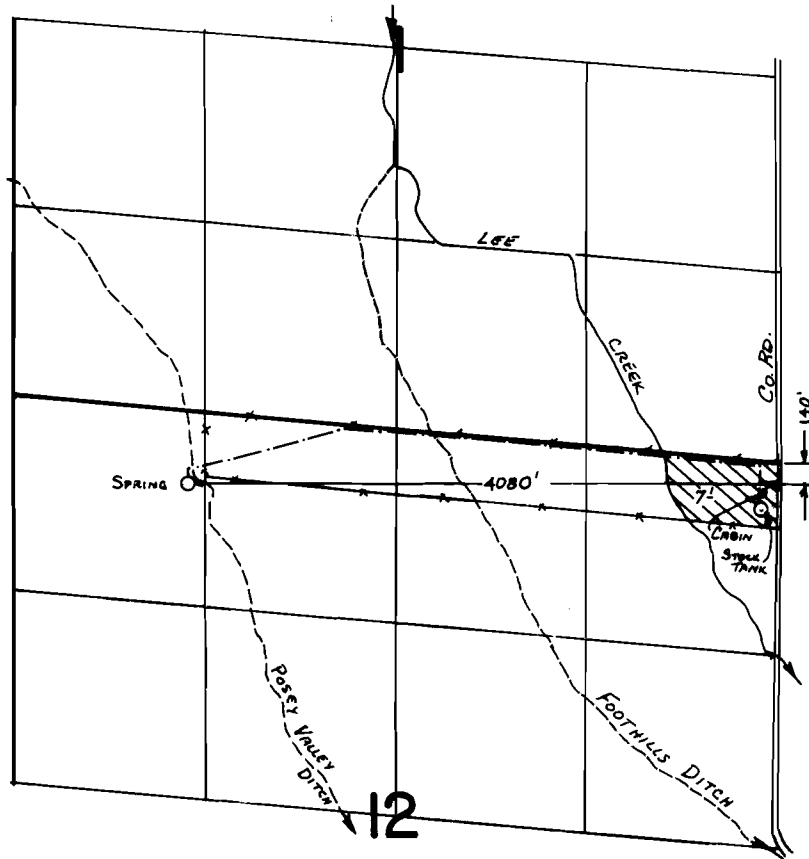


T.8S.,R.45E.,W.M.

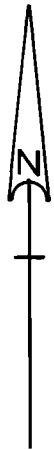

SCALE: 1" = 1320'

FINAL PROOF SURVEY UNDER

Application No. 56126.. Permit No. 43007.....
IN NAME OF

.....ROBERT D. THOMPSON.....

Surveyed Sept. 23. 19.85., by L. M. TOLL.....