


T.33S., R.5W., W.M.

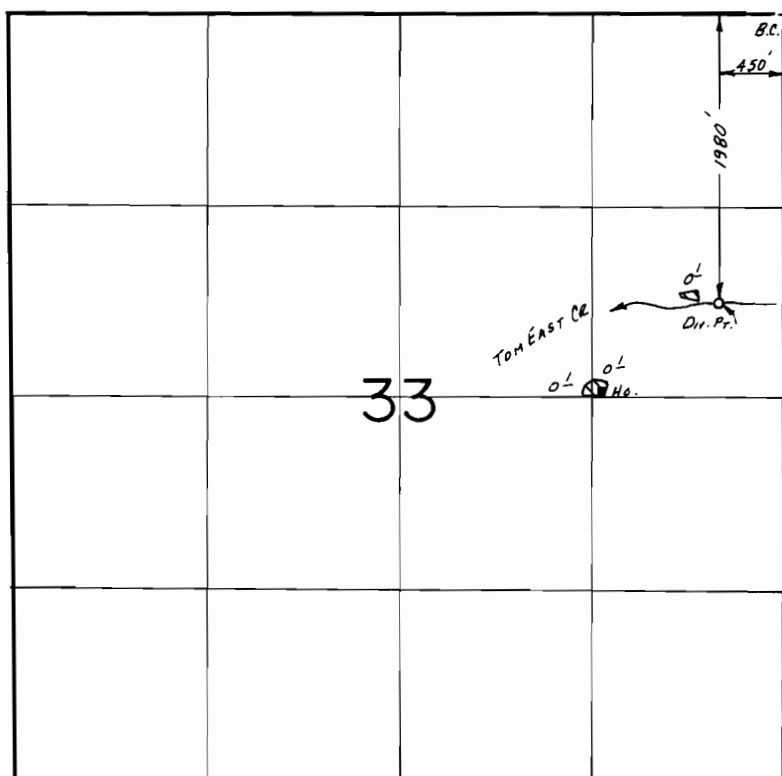

SCALE: 1" = 1320'

FINAL PROOF SURVEY UNDER

Application No. 57690.. Permit No. 43468.....
IN NAME OF

.....ERIC W. GADE.....

Surveyed Sept. 27. 1984, by J.R. WOODROOF.