


T. 30 S., R. 4 W., W.M.

SCALE: 4" = 1 mile

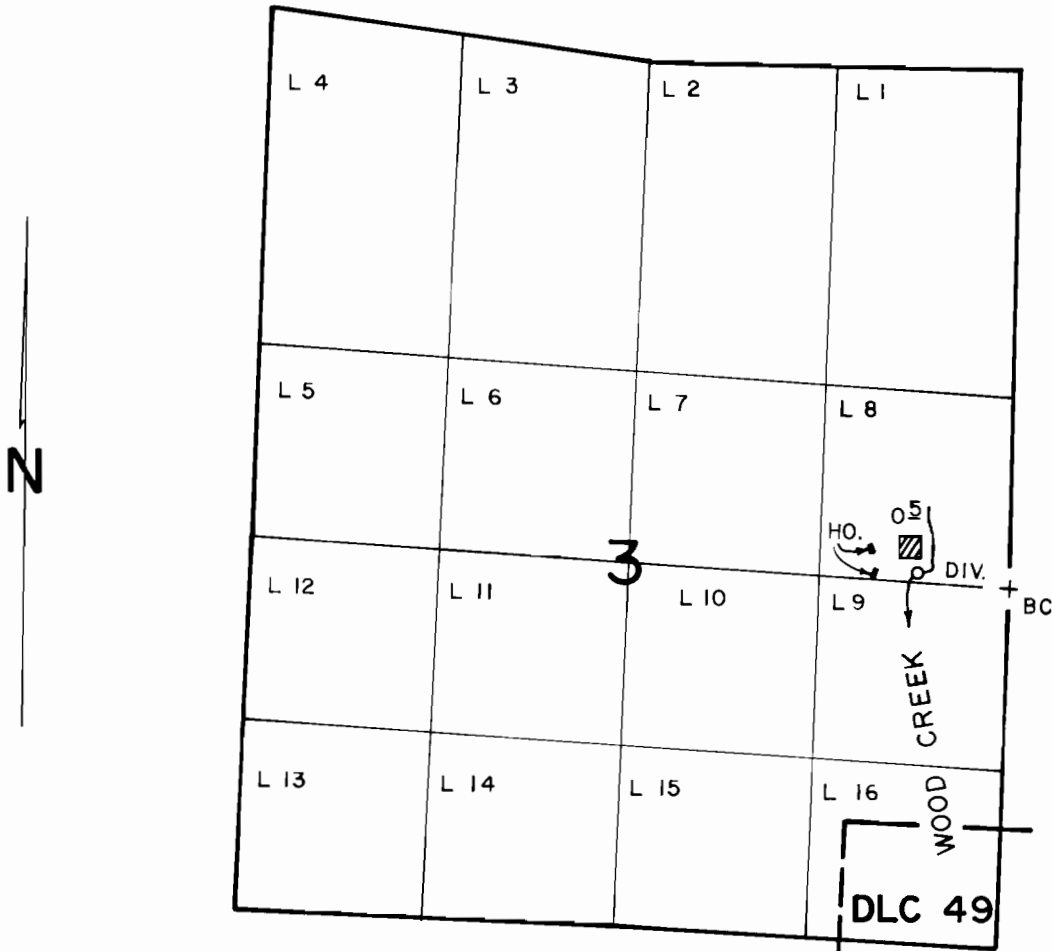

DIV. LOCATION: 90' N & 630' W from E 1/4 CORNER
SEC. 3

FINAL PROOF SURVEY
UNDER

Application No. 57723.. Permit No. 43486.....
IN NAME OF

ROBERT A. STEFFENSON

Surveyed AUG...16, 1983, by J.S. DONALDSON