


T.6S.,R.1E.,W.M.

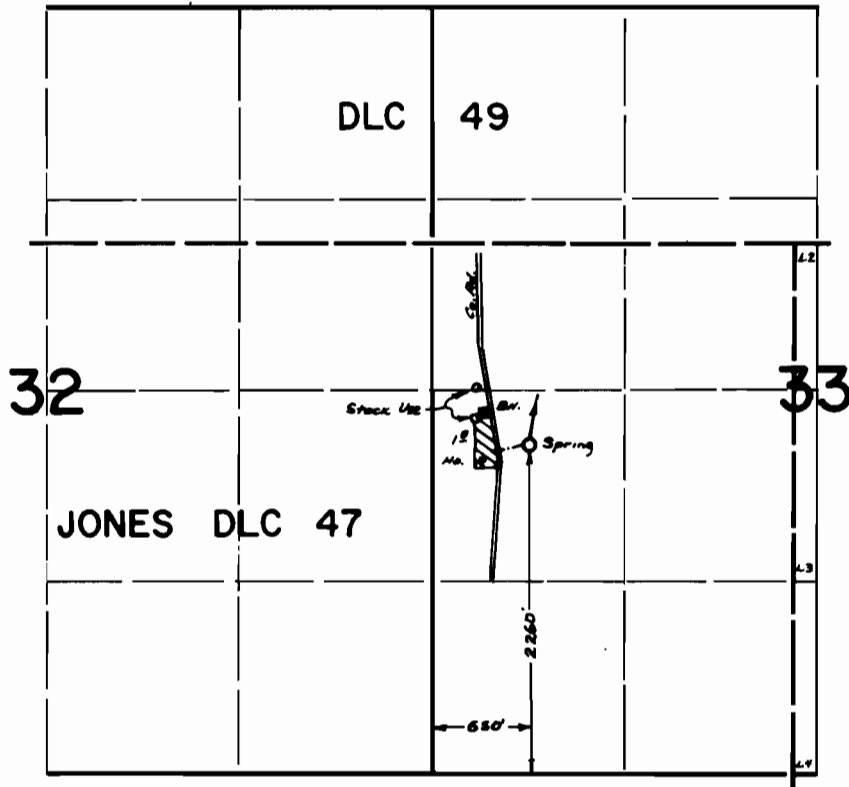

FINAL PROOF SURVEY
UNDER

Application No. 57879.. Permit No. 43512.....
IN NAME OF

MARY L. MCNATT

Surveyed ~~Sept~~ 8 1981, by S.C. BROWN.....