



T. 33 S., R. 2 E., W. M.

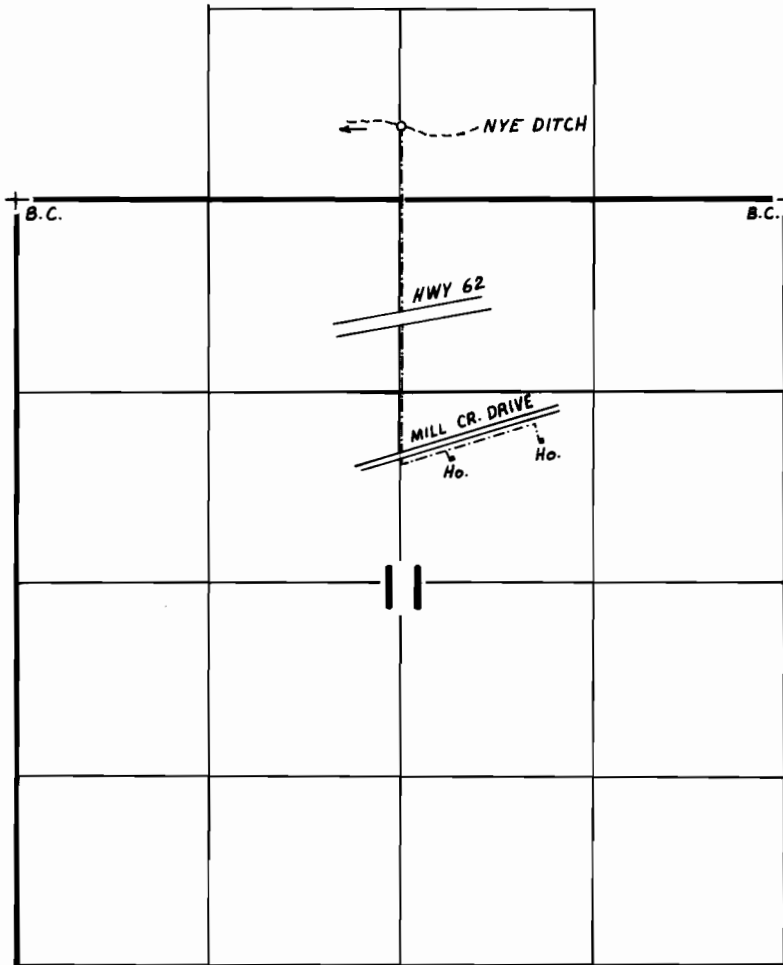

SCALE: 1" = 1320'

T. 32 S., R. 3 E.

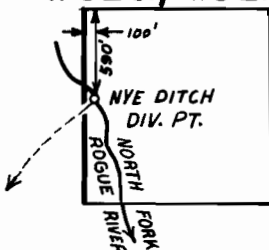

NW1/4 SW1/4
SEC. 29

FINAL PROOF SURVEY
UNDER

Application No. **57949** Permit No. **43594**
IN NAME OF

FRANK E. &/or MARGARET A. STEVENS

Surveyed **MAY 25**, 19**83**, by **B.S. JAMES**