



T. 33 S., R. 2 E., W. M.

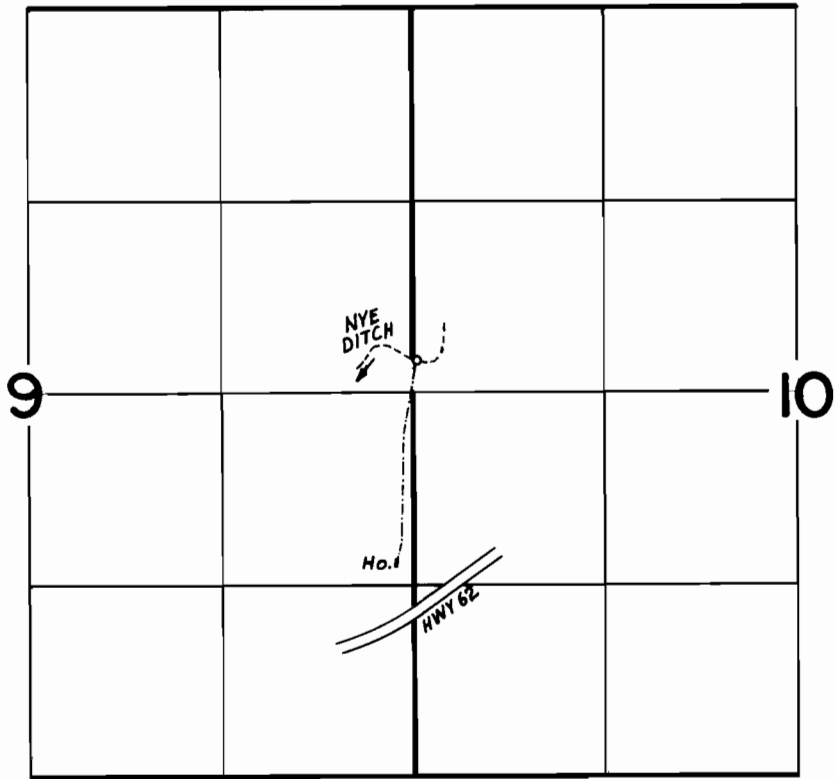

SCALE: 1" = 1320'

T. 32 S., R. 3 E.

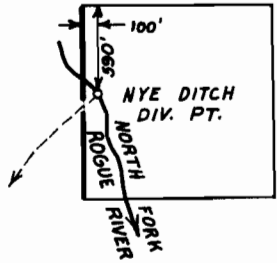

NW 1/4 SW 1/4
SEC. 29

FINAL PROOF SURVEY
UNDER

Application No. **57933** Permit No. **43672**
IN NAME OF

CLINTON W. &/or MYRTLE B. BLAINE

Surveyed **JUNE 16, 1983**, by **B. S. JAMES**