
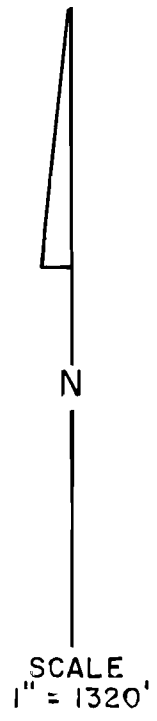


T. 4 S., R. 10 W., W.M.

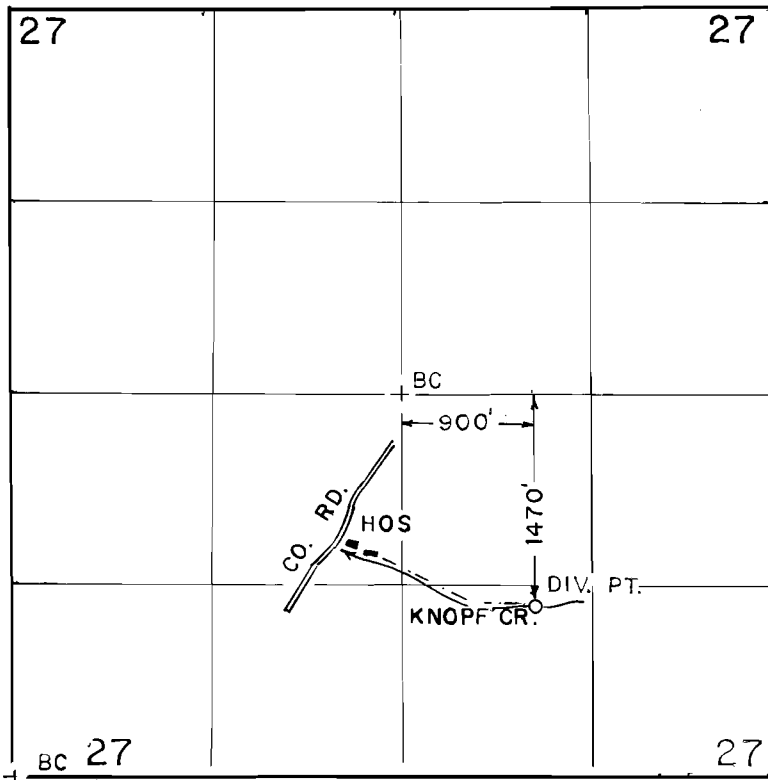

FINAL PROOF SURVEY UNDER

Application No. 58101 Permit No. 43706
IN NAME OF

MARLENE D. KNOPF

Surveyed AUG 2 1984, by P. PAGTER