


T.27S., R.3W., W.M.

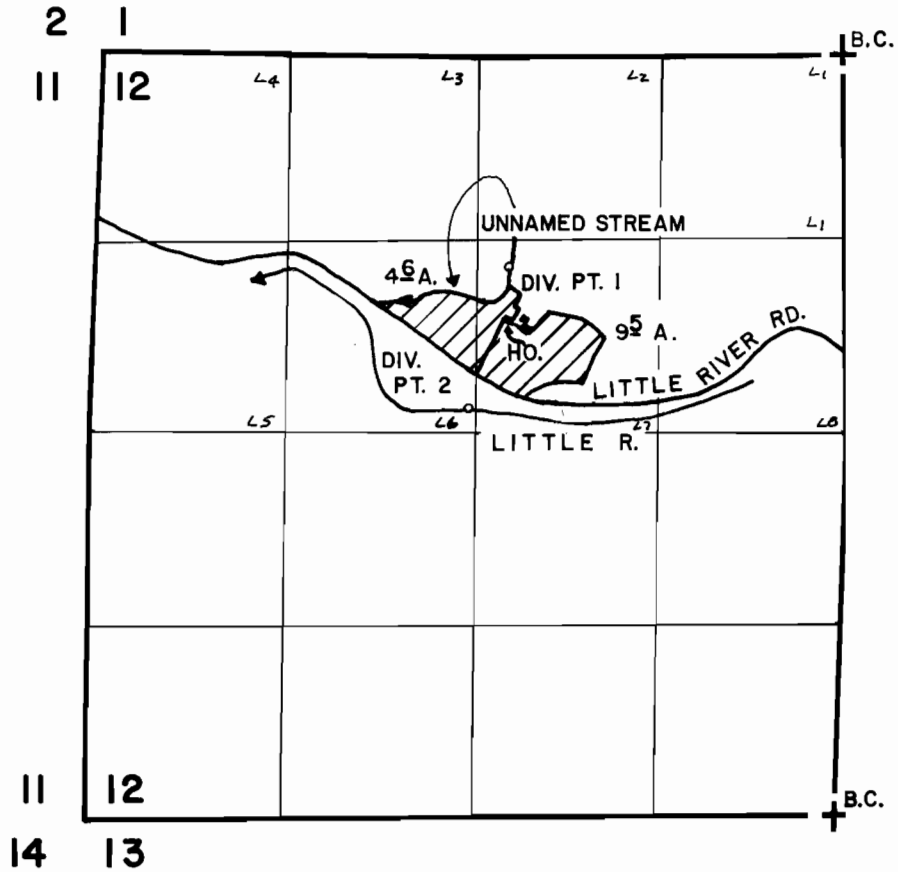

DIV. PT. 1 LOCATED 1460' S. & 2300' W. FROM NE COR. SEC. 12.
 DIV. PT. 2 LOCATED 2420' S. & 2570' W. FROM NE COR. SEC. 12.

SCALE: 4" = 1 MILE

FINAL PROOF SURVEY UNDER

Application No. 57314 Permit No. 43746
 IN NAME OF

ESTON DUMONT

Surveyed JULY 16, 1984, by D. K. CLARK