



T.33S., R.2E., W.M.

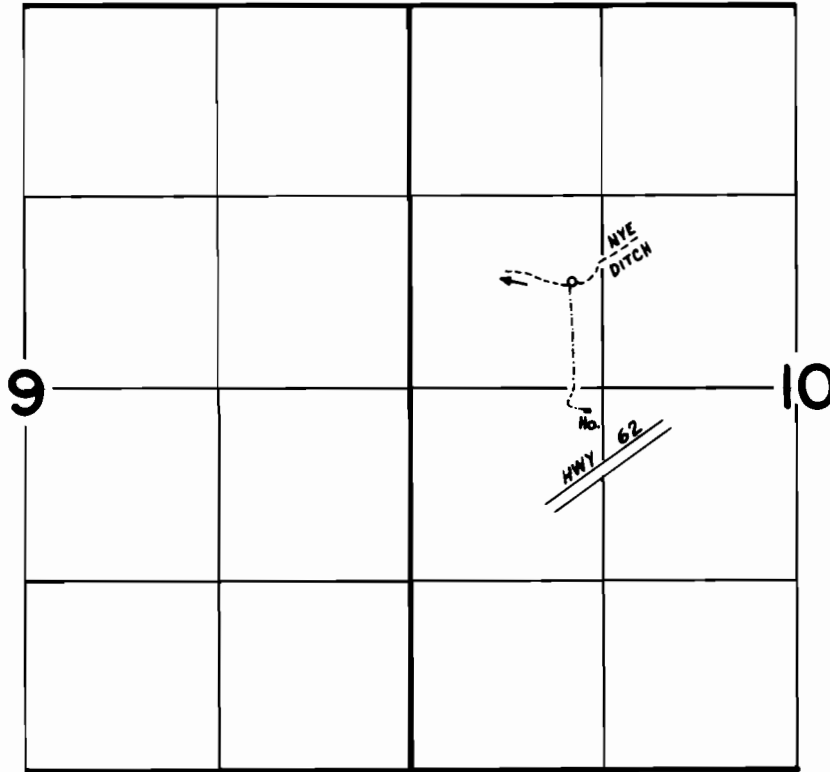

T.32S., R.3E., W.M.

SCALE: 1" = 1320'

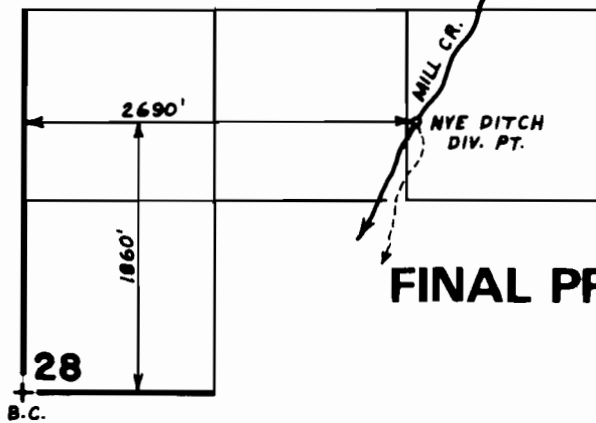

**FINAL PROOF SURVEY**  
UNDER

Application No. **58543** Permit No. **44238**  
IN NAME OF

**FRANCES I. ADAMS**

Surveyed **JUNE 16** 19**83**, by **B. S. JAMES**