


T. 1S., R. 9W., W.M.

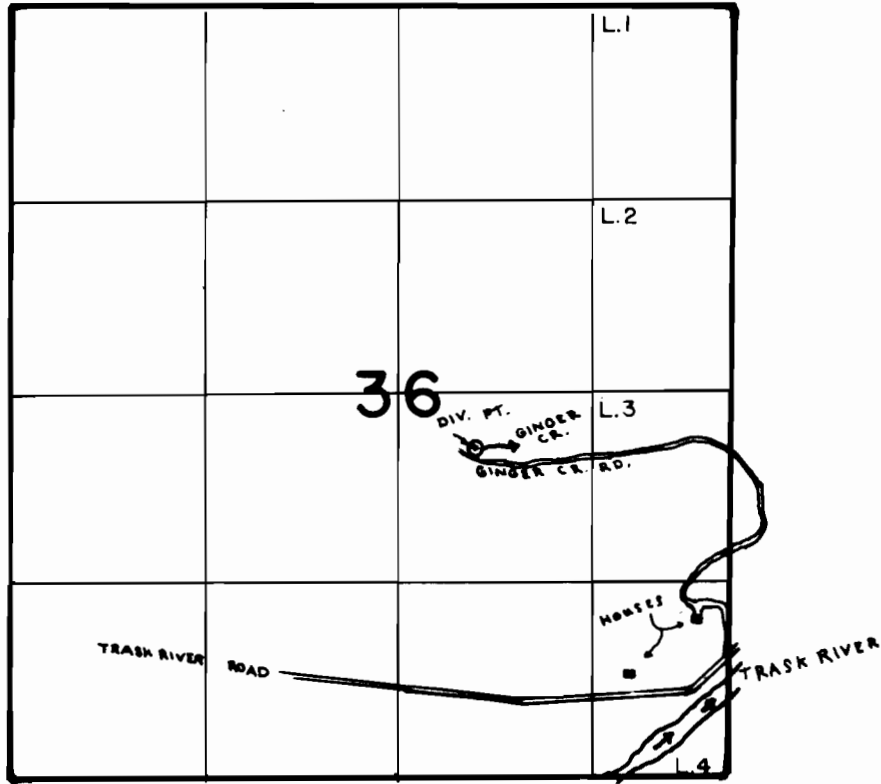

DIV. PT. LOC.: 2270' N. & 3200' E. OF SW COR. SEC. 36

FINAL PROOF SURVEY
UNDER

Application No. 59200 Permit No. 44458
IN NAME OF

.....DENIS SCHMITZ.....

Surveyed OCT. 1925, by PAGTER, P.