


T.18S., R.11W. WM.

16

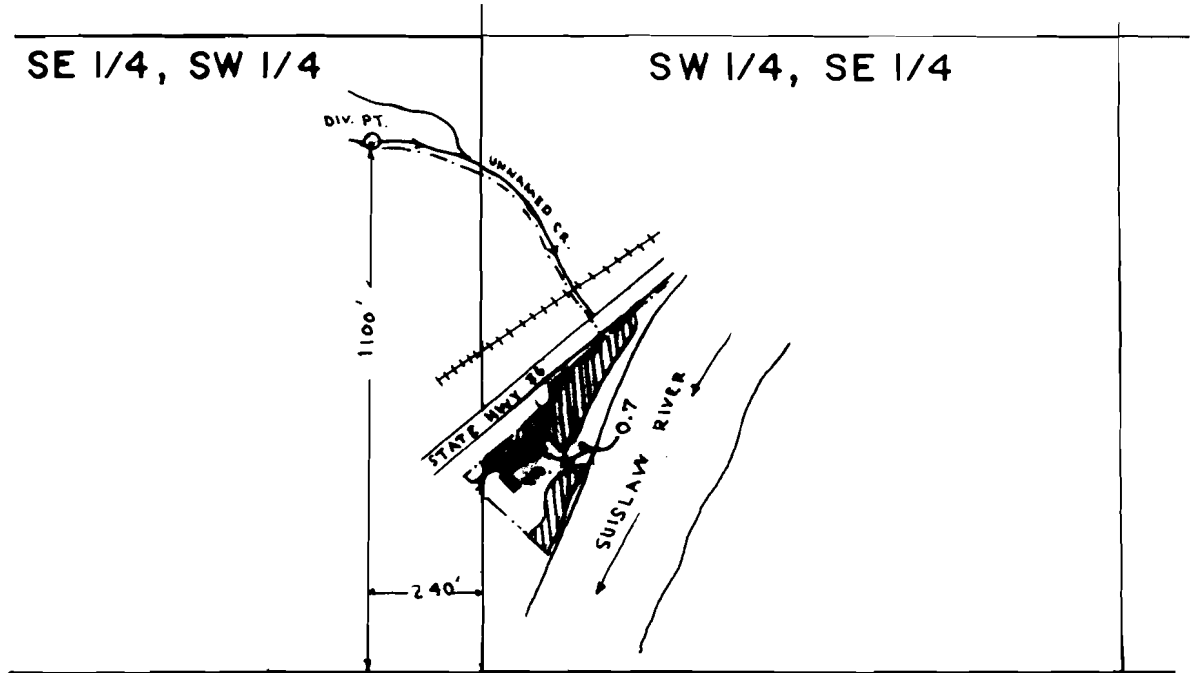

1" = 400'

FINAL PROOF SURVEY
UNDER

Application No. 58871... Permit No. 44585...
IN NAME OF

EARL & MARGARET E. FINLEY

Surveyed N.O.V. 1983., by P. PAGTER.....