


T.4S. R.2E. W.M.

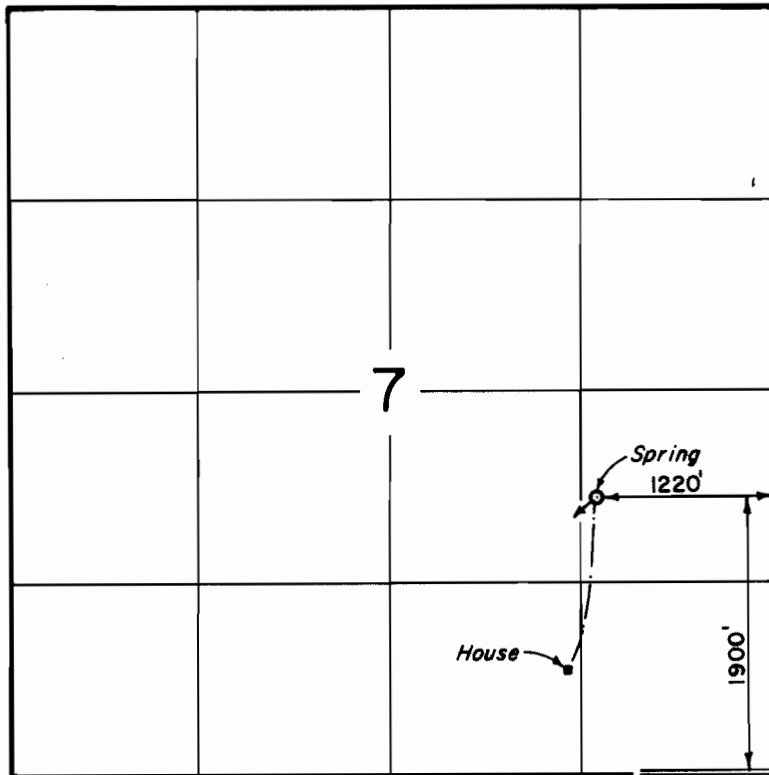

FINAL PROOF SURVEY
UNDER

Application No. 59233 Permit No. 44727.....

IN NAME OF

PAUL & ELEANOR DIX.....

Surveyed AUG. 7, 1981, by [Signature].....