


T. 30S., R. 4 W., W.M.

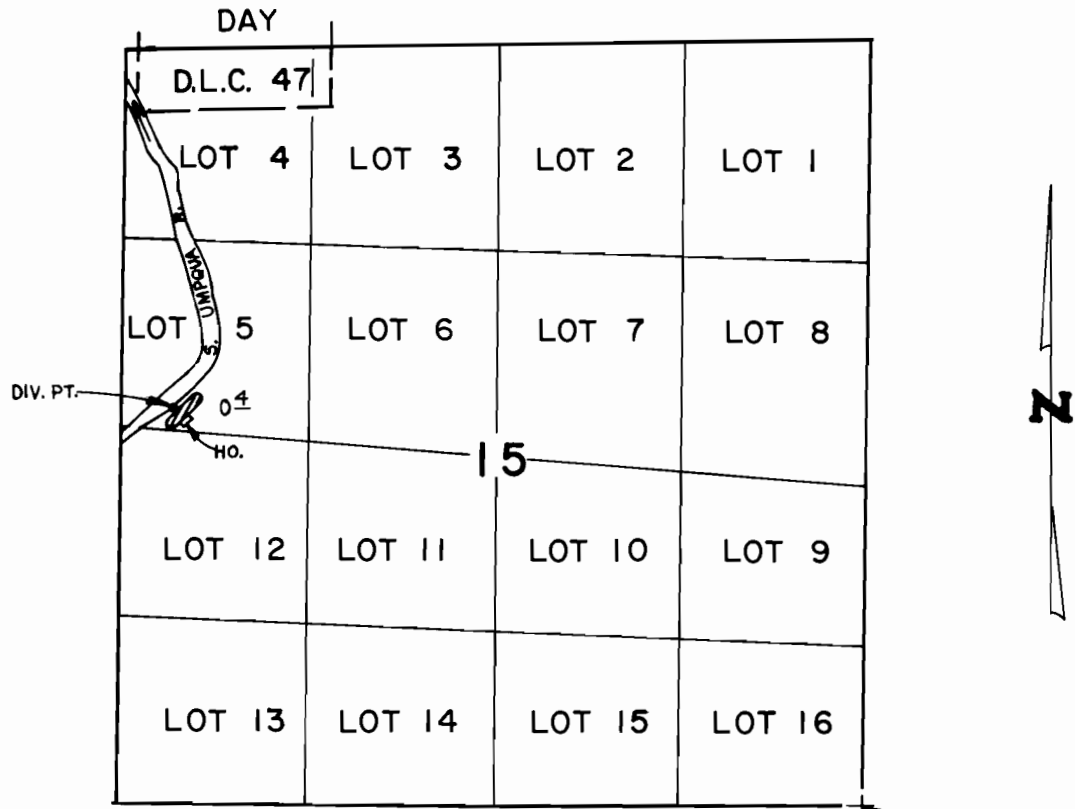

DIV. PT. LOCATED 135'N. & 350'E. FROM W. 1/4 COR. SEC. 15

SCALE: 4" = 1 mile

FINAL PROOF SURVEY

UNDER

Application No. 60298.. Permit No. 45153.....

IN NAME OF

LORENZO T. & JOAN W. PARRA

Surveyed AUG. 23, 1983, by J. S. DONALDSON