


T. 33 S., R. 6 W., W.M.

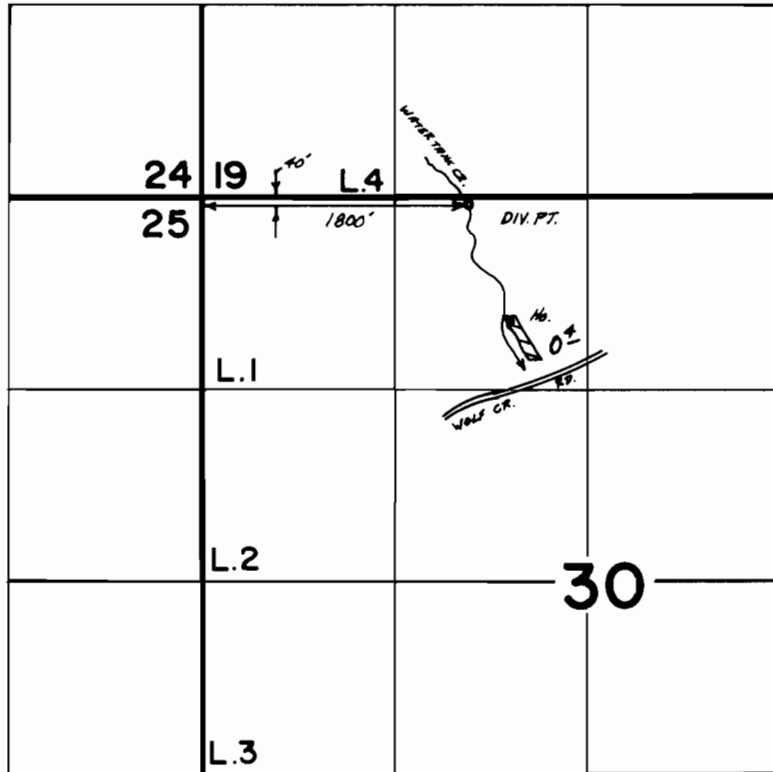

Scale 4" = 1 Mile

FINAL PROOF SURVEY UNDER

Application No. ~~60459~~ Permit No. ~~45658~~.....
IN NAME OF

DONALD K. FORD

Surveyed Aug. 30 1984, by J. R. WOODROOF